


T. 17S., R. 10W., W. M.

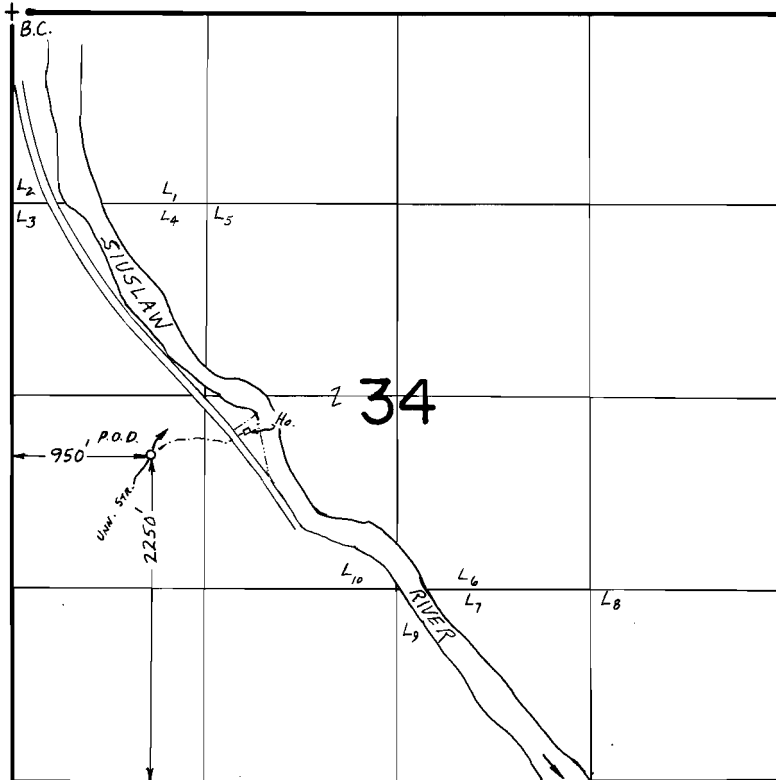

Scale : 1" = 1320'

FINAL PROOF SURVEY
UNDER

Application No. 50438.. Permit No. 38094.....
IN NAME OF

.....**JOHN W. LANDON**.....

Surveyed **AUG. 8. 1979.**, by **S.C. BROWN**.....