


T. 3 N., R. 10 W., W. M.

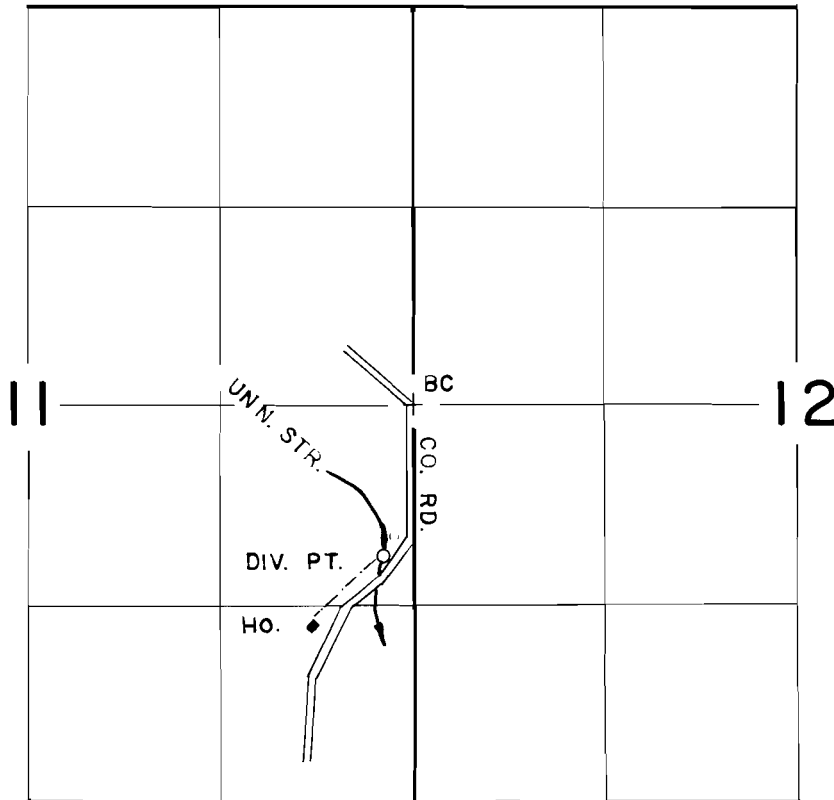

SCALE
1" = 1320'

DIV. PT. LOC. 1040' S & 210' W OF E 1/4 COR. SEC. 11

FINAL PROOF SURVEY UNDER

Application No. 57353.. Permit No. 43203.....
IN NAME OF

JAMES R. DEY.....

Surveyed MAY 22 1984, by P. PAGTER.....