



T. 39 S., R. 3 W., W. M.

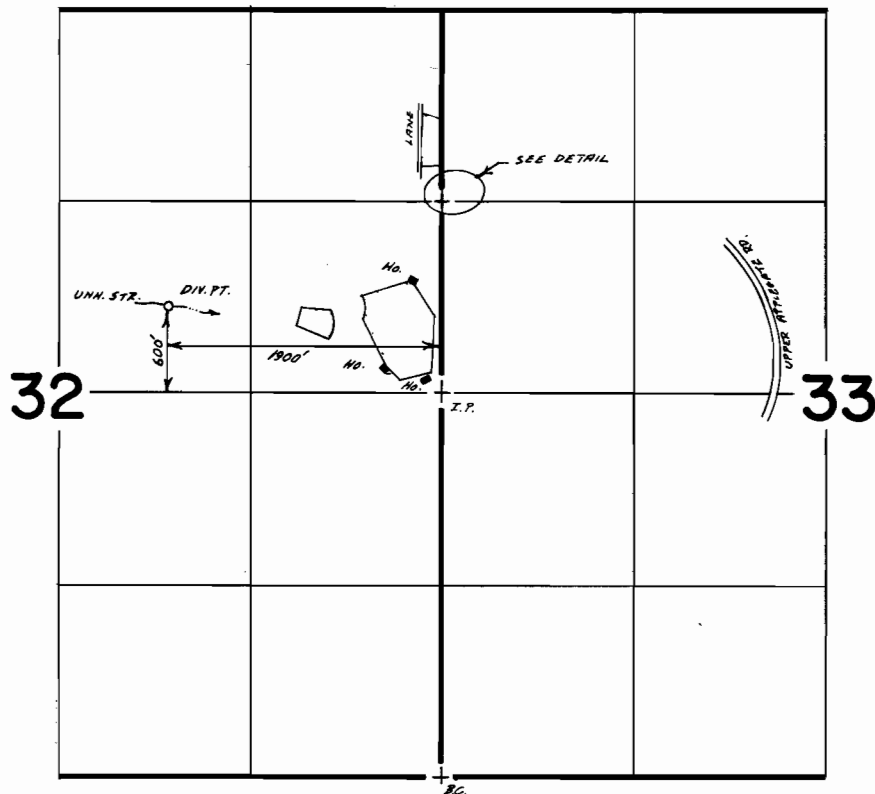

Scale 1"=1320'

DETAIL

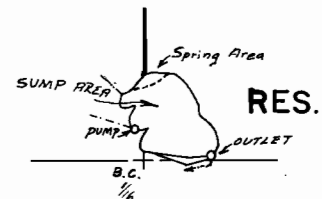

Scale 1"=400'

FINAL PROOF SURVEY UNDER

Application No. 59855.. Permit No. 44987.....
IN NAME OF

.....MARGARET L. DYRDAHL.....

Surveyed July 17, 1985, by B.S. JAMES.....
Aug. 21, 1985,