


P-45367
C-58902

T.14S.,R.32E.,W.M.

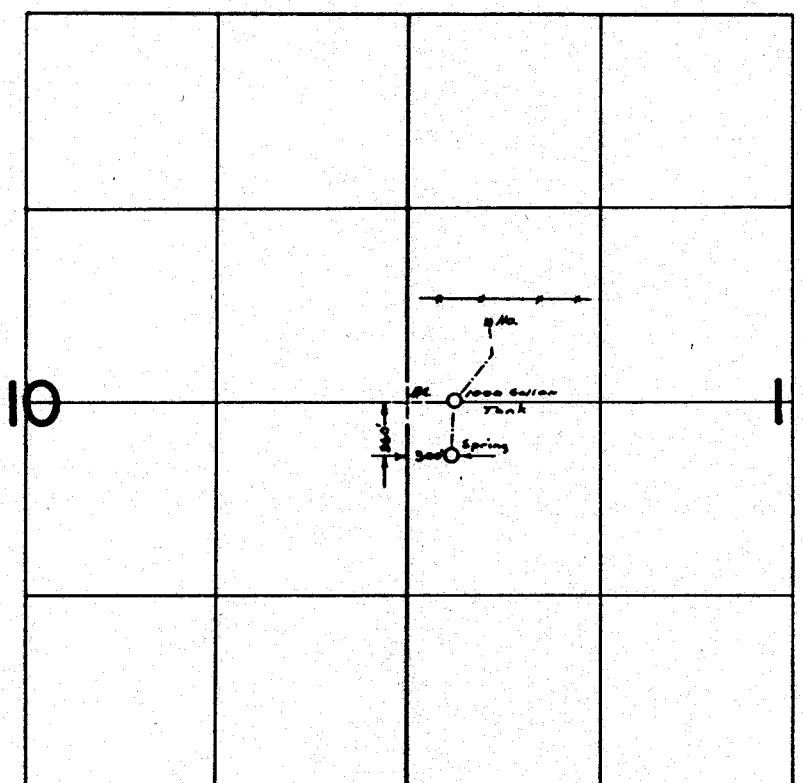

FINAL PROOF SURVEY
UNDER

Application No. 60785.. Permit No. 45367.....
IN NAME OF

LYLE E. & HELEN R. VICKERS..

Surveyed July..27... 19.83., by R..W..Cattel.....