


T. 26 S., R. 3 W., W.M.

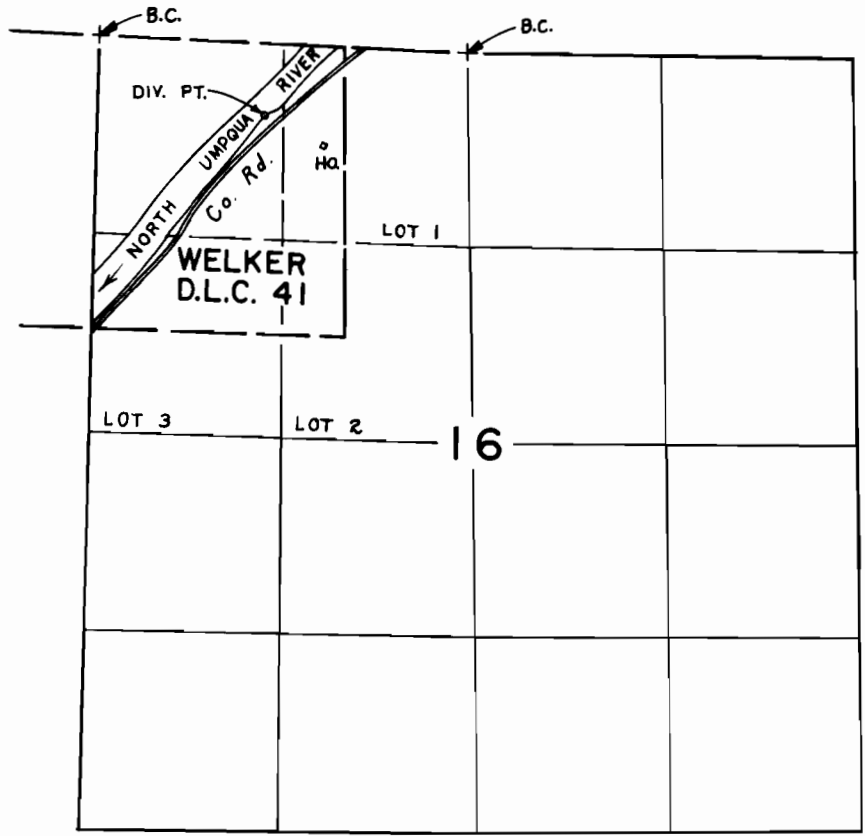

DIV. PT. LOCATED 550'S. & 1,135'E. FROM N.W. COR. SEC. 16

SCALE: 4" = 1 mile

FINAL PROOF SURVEY UNDER

Application No. 61231..... Permit No. 45609.....
IN NAME OF

GERALD A. PATTISON.....

Surveyed JUL 26 1984, by L. CASHION..