


T.7S.,R.46E.,W.M.

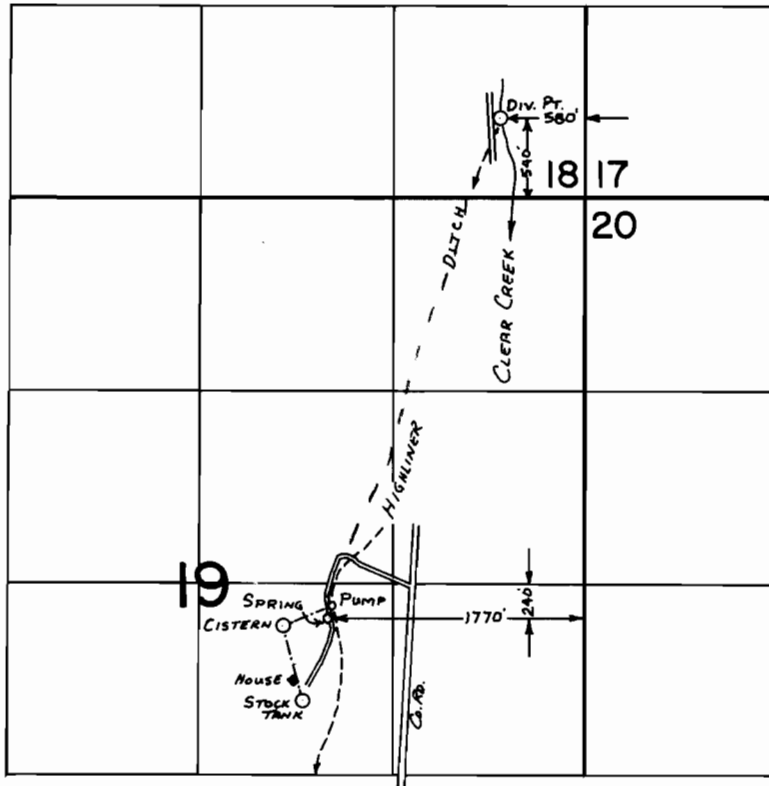

SCALE: 1" = 1320'

FINAL PROOF SURVEY UNDER

Application No. 61140 45838
61636 Permit No. 45839.....
IN NAME OF

.....DAVID G. OSMAN.....

Surveyed Sept. 26, 1985, by L. M. TOLL.....