
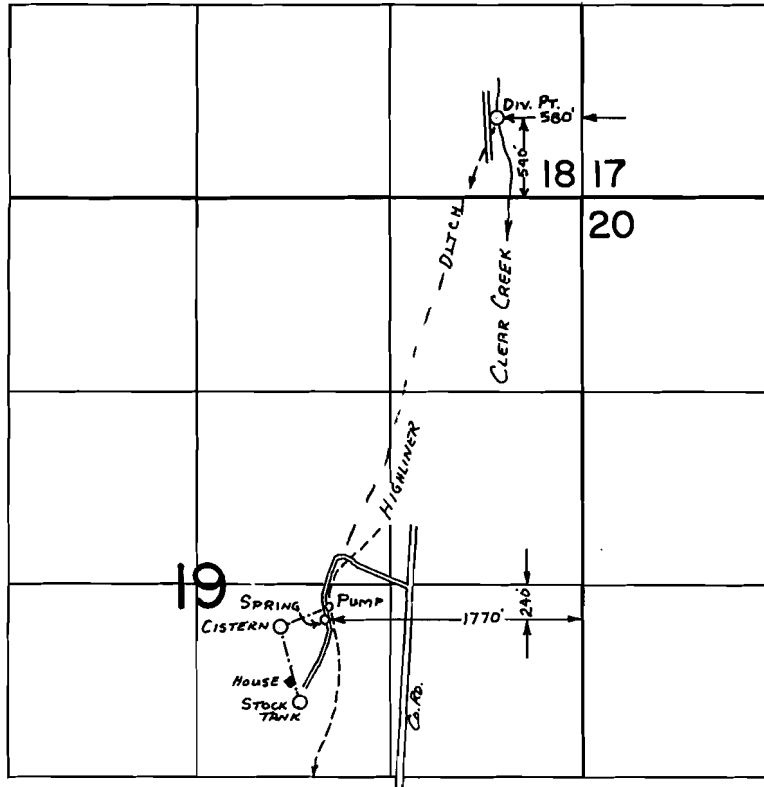


T.7S.,R.46E.,W.M.

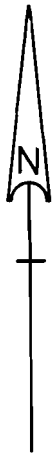

SCALE: 1" = 1320'

FINAL PROOF SURVEY UNDER

Application No. 61140 61636 Permit No. 45838 45839
IN NAME OF

DAVID G. OSMAN

Surveyed Sept. 26 1985, by L. M. TOLL