


T.3S., R.9W., WM.

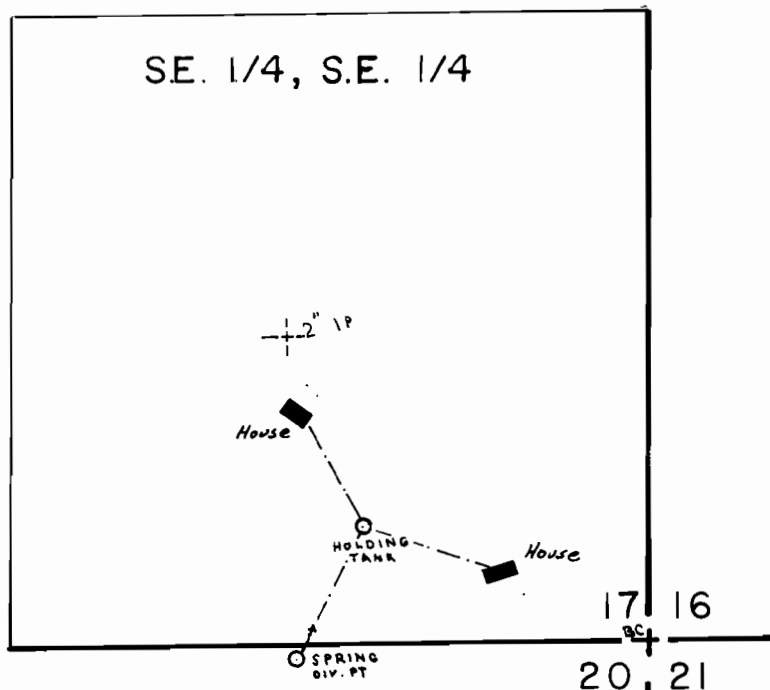

DIV. PT. LOC.:
30' S. & 730' W. OF
SE COR. SEC. 17

SCALE:
1" = 400'

FINAL PROOF SURVEY
UNDER

Application No. 62,370.. Permit No. 45,973....
IN NAME OF

...WILLIAM...F...JORDAN.....

Surveyed OCT. 26 19.83, by PAGIER, P...