


T. 29S. R. 6W. W.M.

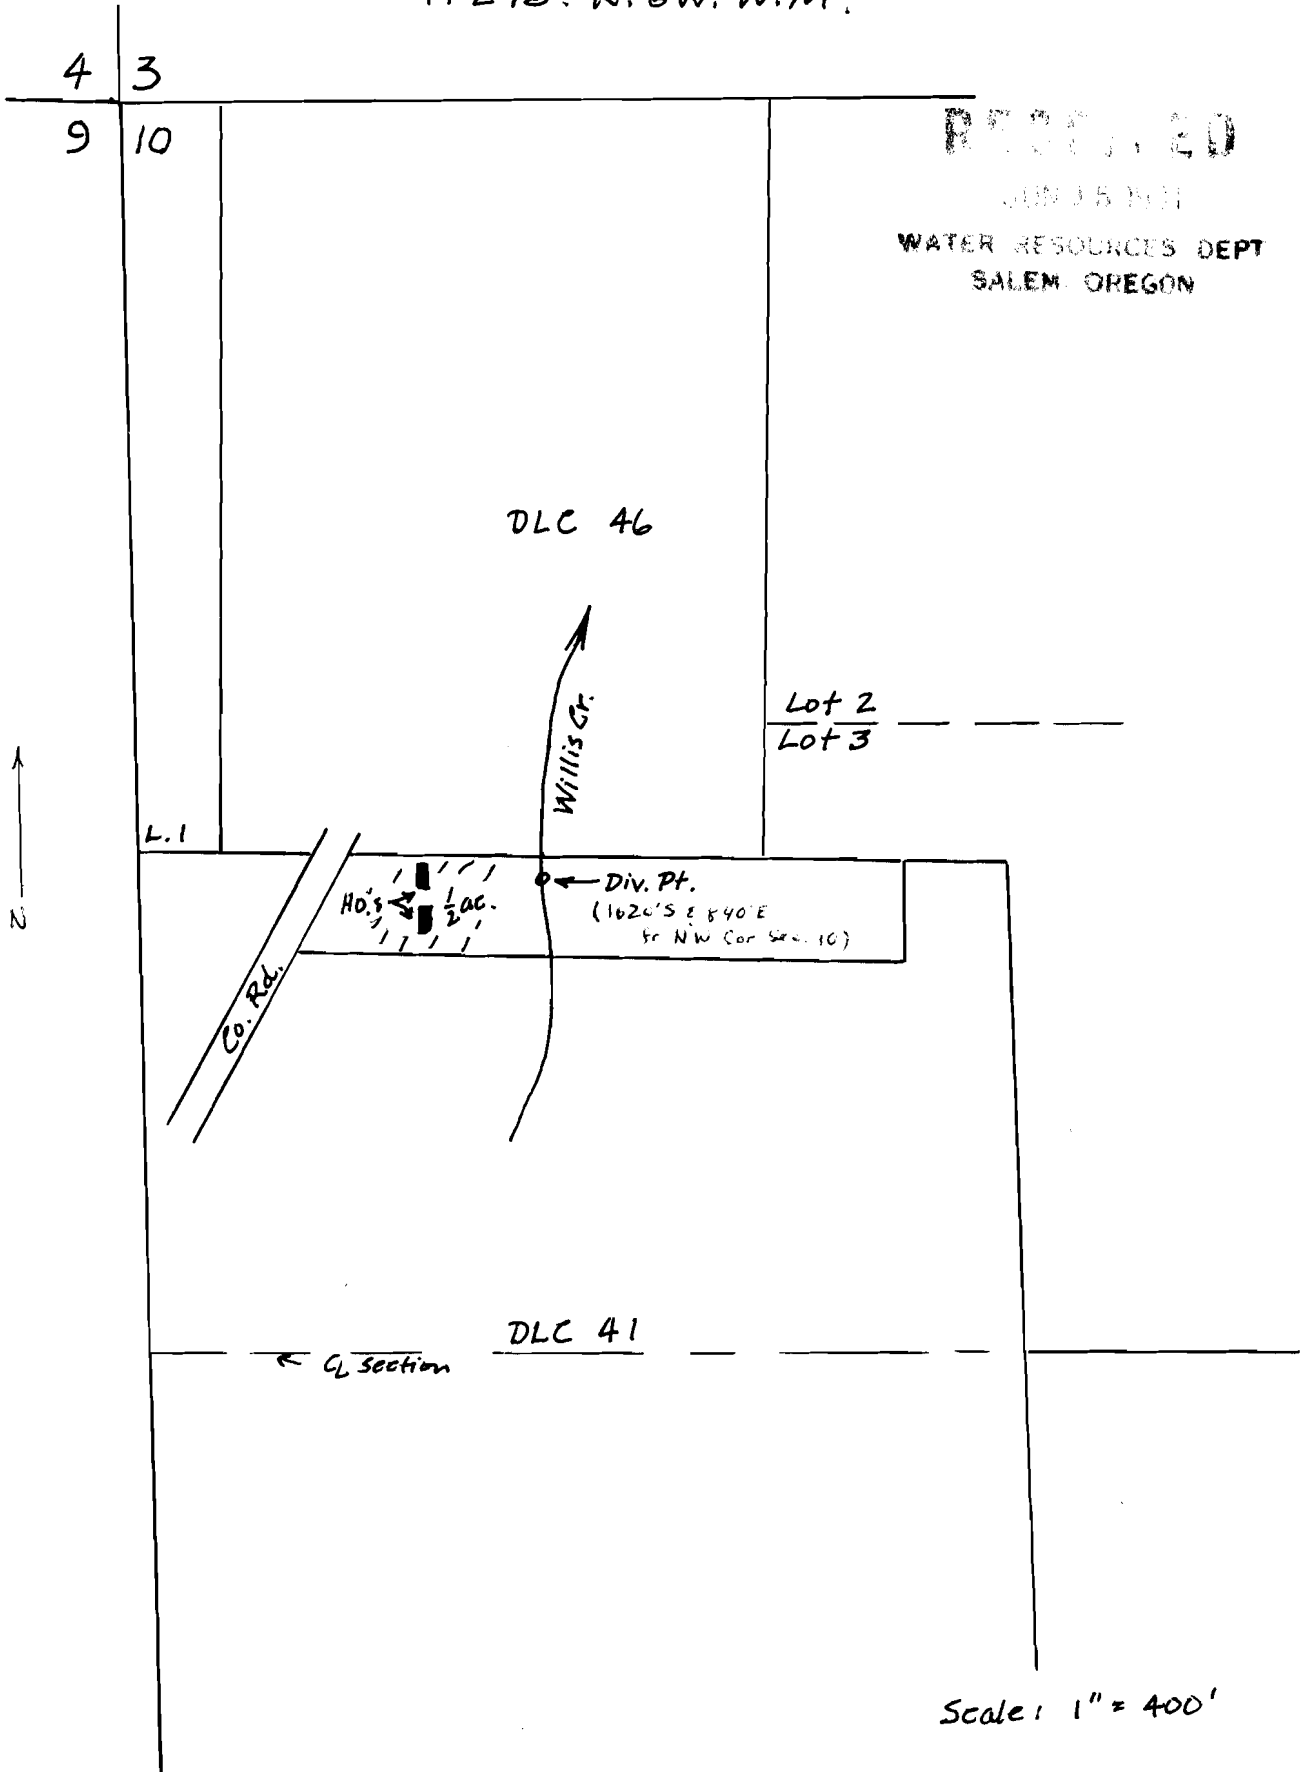

Application No. 61793
Permit No. 46033