


# T. 36S., R. 14 W., W. M.

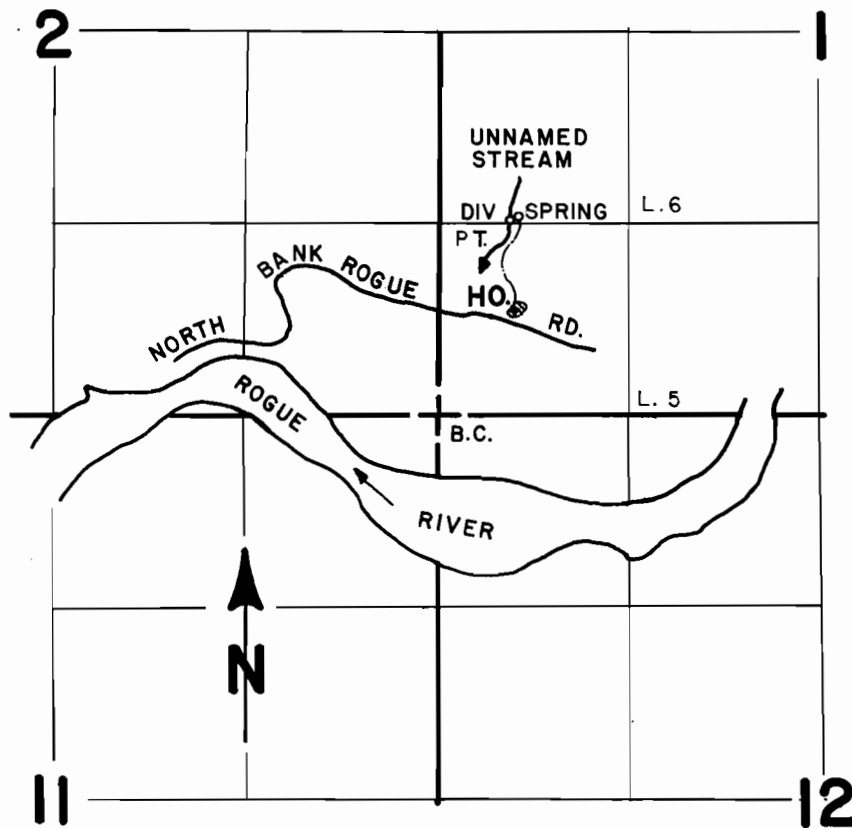

SPRING LOCATED 1360' N. & 560' E. OF SW COR. SEC. 1.  
 DIV. PT. LOCATED 1340' N. & 480' E. OF SW COR. SEC. 1.

SCALE: 4" = 1 MILE

## FINAL PROOF SURVEY UNDER

Application No. 60841 Permit No. 46069  
 IN NAME OF

ANNA WATSON

Surveyed SEPT. 24 1986, by J. M. SCHMORDE