


T1S., R.9W., W.M.

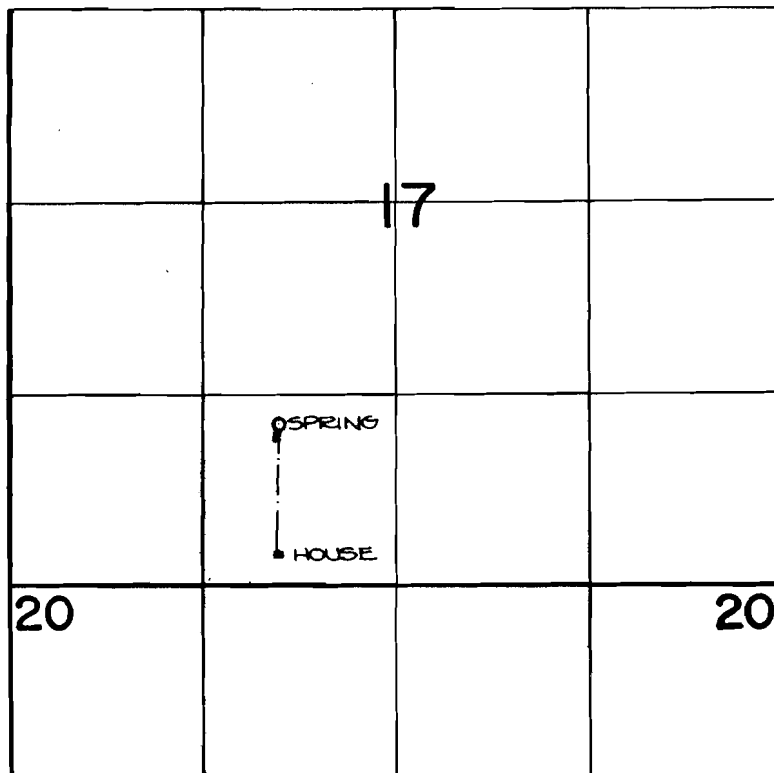

SPRING LOCATION: 1100 FT. N. AND 1050 FT. E. FROM
THE S.W. CORNER OF SECTION 17.

FINAL PROOF SURVEY
UNDER



Application No. 62257... Permit No. 46169.....
IN NAME OF

SCALE: 4" = 1 MILE

.....MELVIN.....H.....WILLIAMS.....

Surveyed JUNE 11, 1984, by P. Patten.....