


T. 3S., R. 1W., W.M.

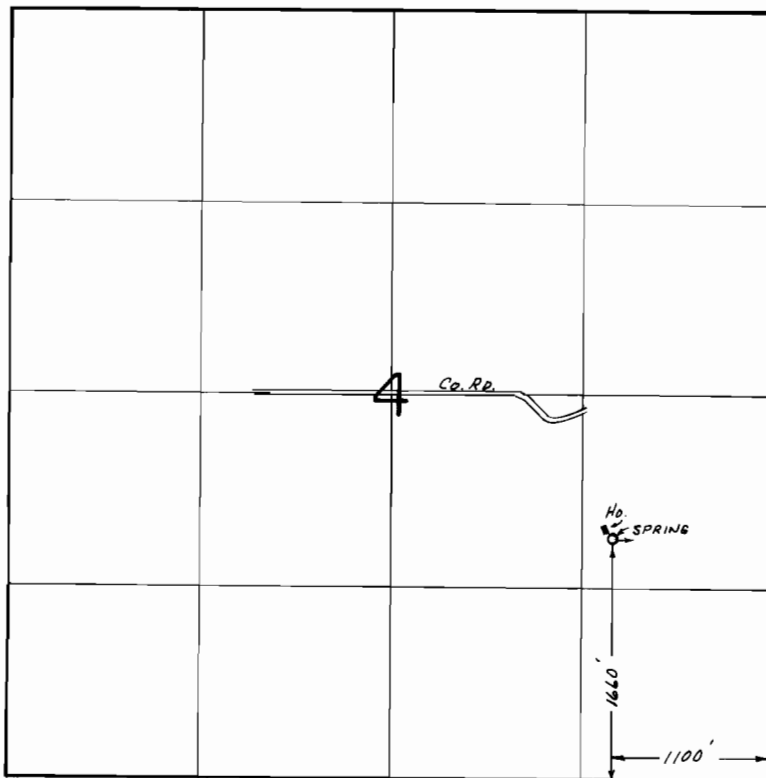

SCALE: 1" = 1320'

FINAL PROOF SURVEY
UNDER

Application No. 62424... Permit No. 46550.....
IN NAME OF

.....ROBERT N. JAEGER.....

Surveyed Aug. 13... 19.84., by J.R. WOODROOF.