


T. 18 S., R. 10 W. WM.

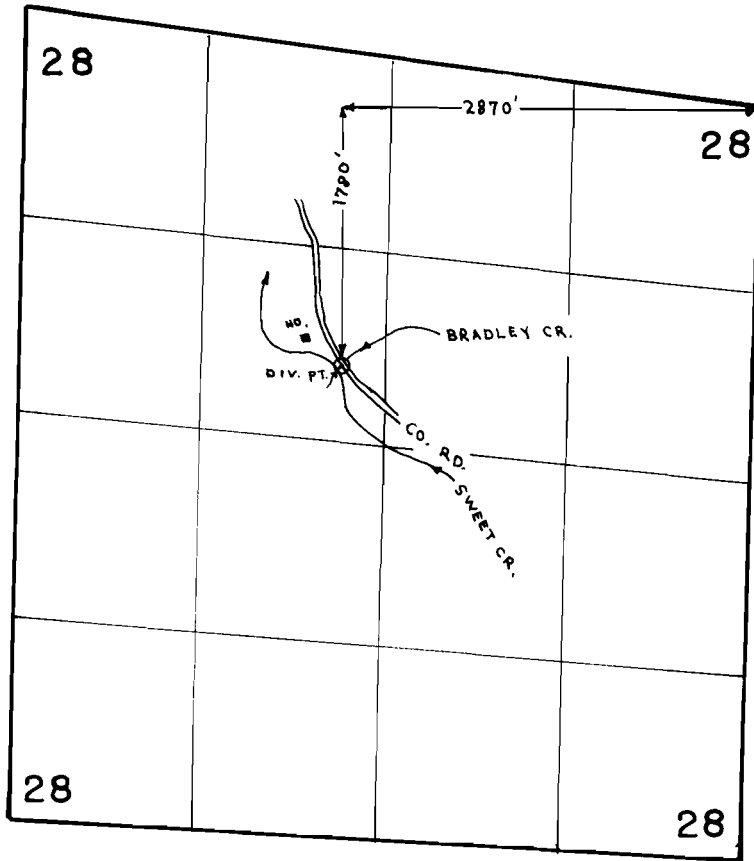

FINAL PROOF SURVEY
UNDER

Application No. 61238.. Permit No. 46614.....
IN NAME OF

PAUL DAVID & DOLLY MAE MILLER

Surveyed NOV. 12 1983, by P. PAGTER.....