
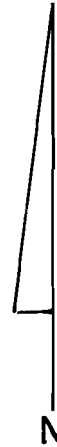


T. 1 N., R. 9 W., W.M.

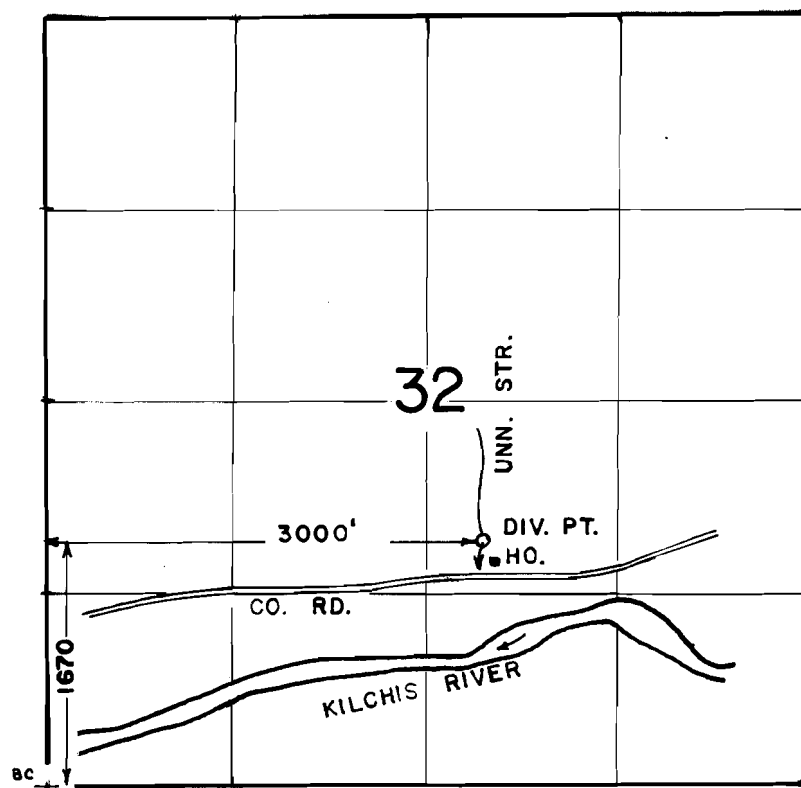

SCALE
1" = 1320'

FINAL PROOF SURVEY
UNDER

Application No. 63071 Permit No. 46653
IN NAME OF

DARRELL & NANCY MONA

Surveyed MAY 24 1984, by P. PAGTER