


T. 9 S., R. 1 E., W.M.

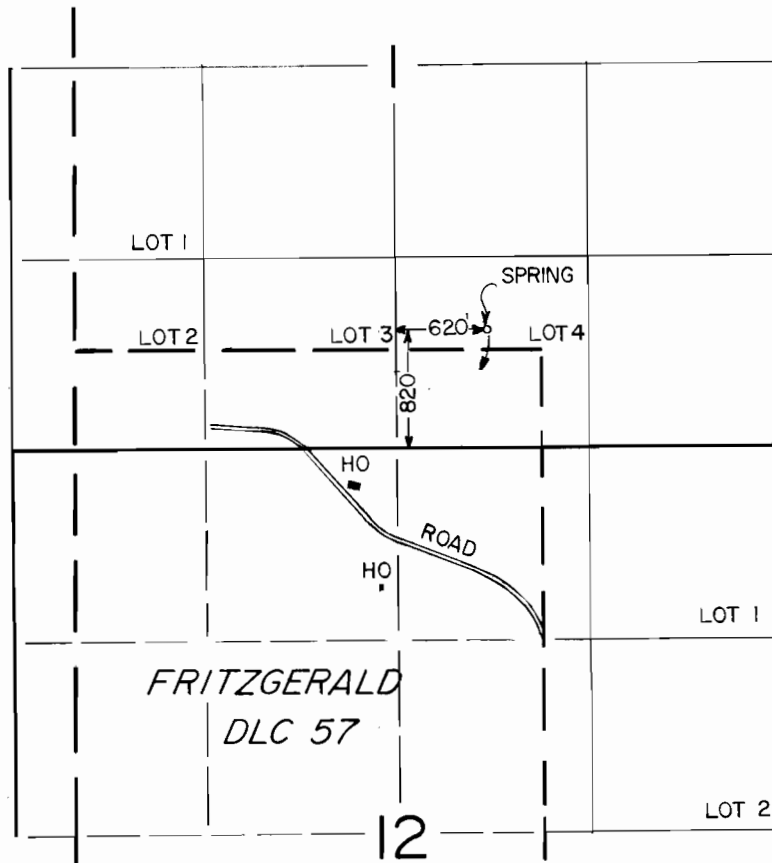

SCALE: 1" = 1320'

FINAL PROOF SURVEY UNDER

Application No. 63968... Permit No. 47060...
IN NAME OF

EDITH A. TIETZE RICHMOND NIELSON

Surveyed APRIL 23, 1985, by P.R. PAGTER