


T. 13 S., R. 9 E., W.M.  
SECTION 15

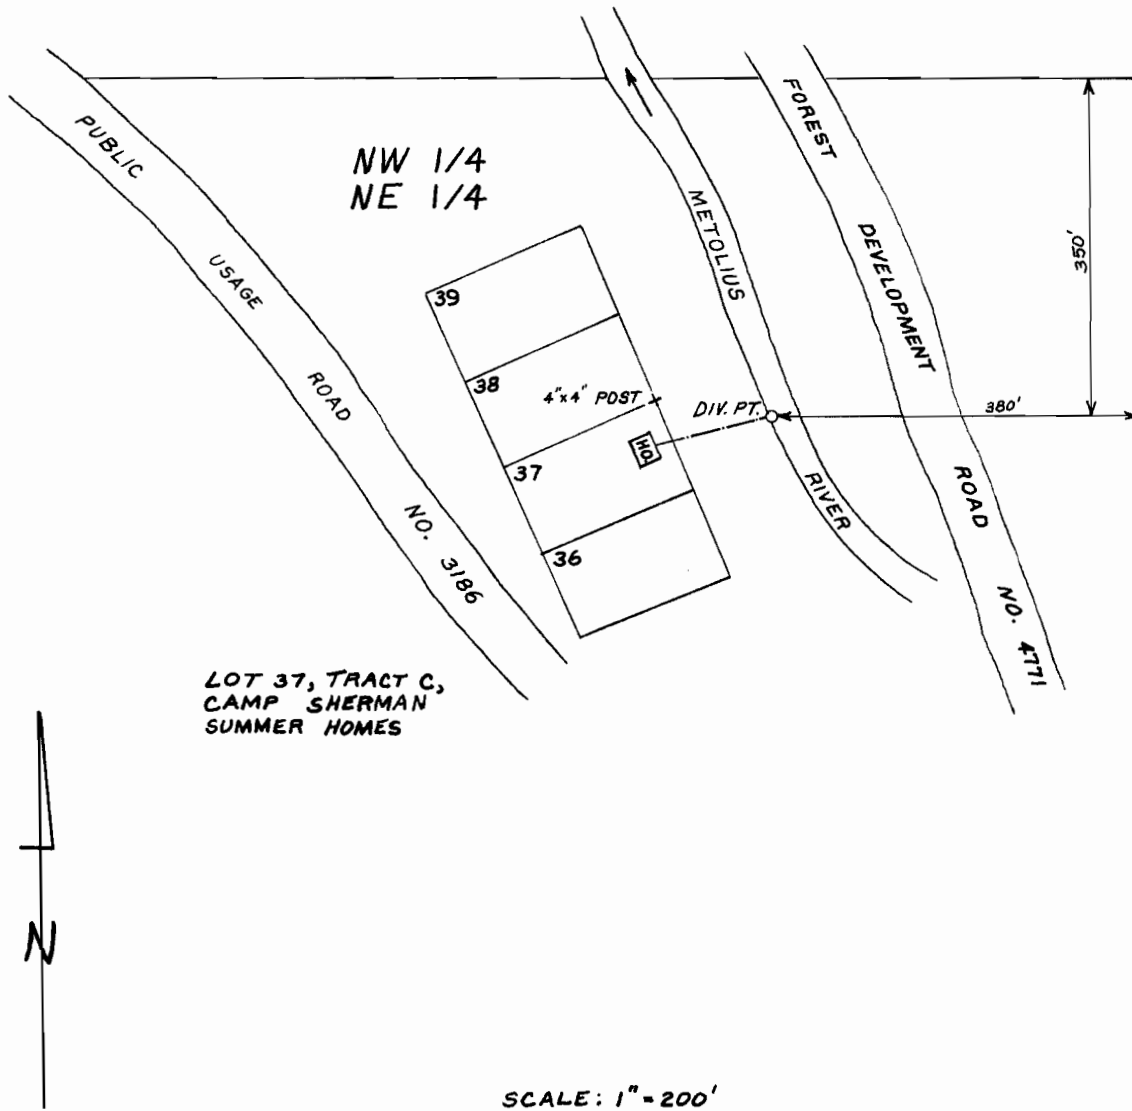

LOT 37, TRACT C,  
CAMP SHERMAN  
SUMMER HOMES

FINAL PROOF SURVEY

UNDER

Application No. 64731 Permit No. 47503

IN NAME OF

ERNEST & JOY B. ZAPF

Surveyed FEB. 28, 19. 85, by LESLIE OLSON