


P-47574
C-58924

T.12S., R.34E., W.M.

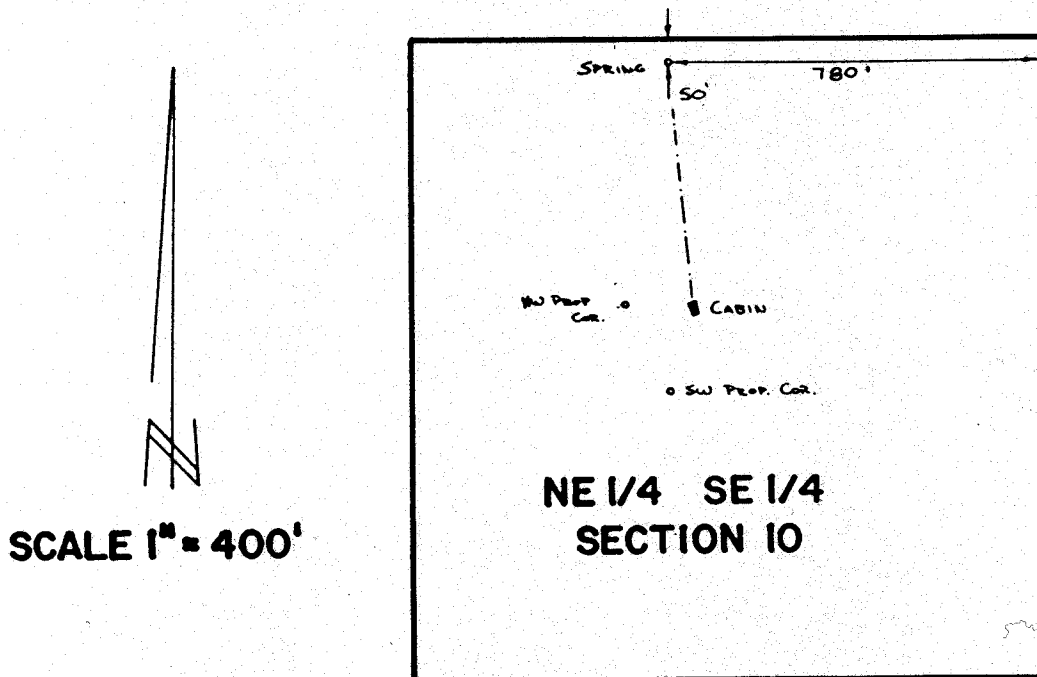

FINAL PROOF SURVEY
UNDER

Application No. **65102** Permit No. **47574**
IN NAME OF

ALTON B. JACQUELINE RAPP

Surveyed **4-7** 1986, by **L. T. Rapp**