


T. 13 S., R. 9 E., W. M.
SECTION 15

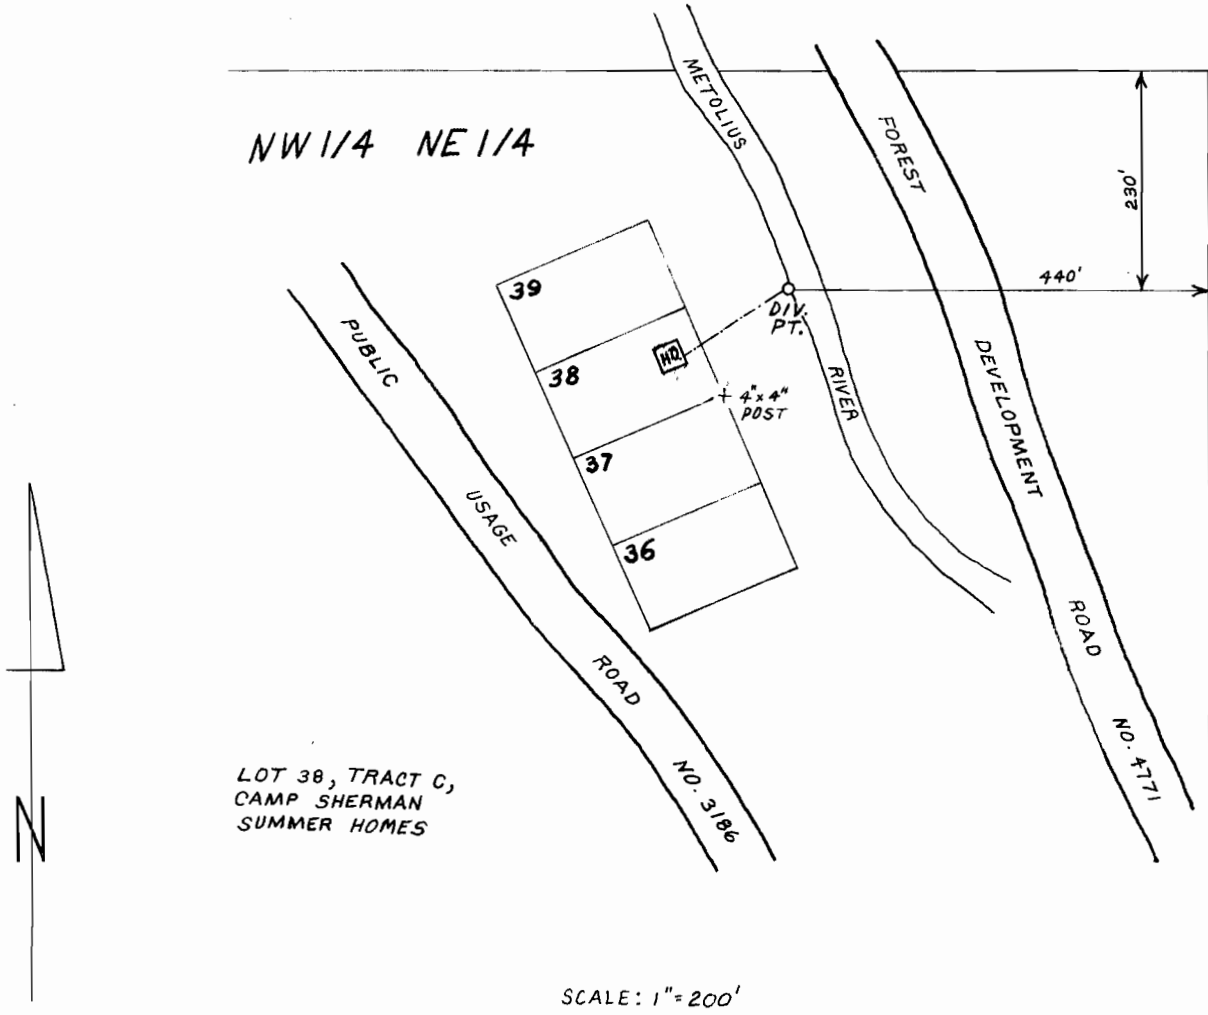

FINAL PROOF SURVEY

UNDER

Application No. 65238 Permit No. 47665

IN NAME OF

A. LEE FOSTER

Surveyed FEB. 28. 19 85. by LESLIE OLSON.