


T. 13S., R. 9E., W.M.
SECTION 10

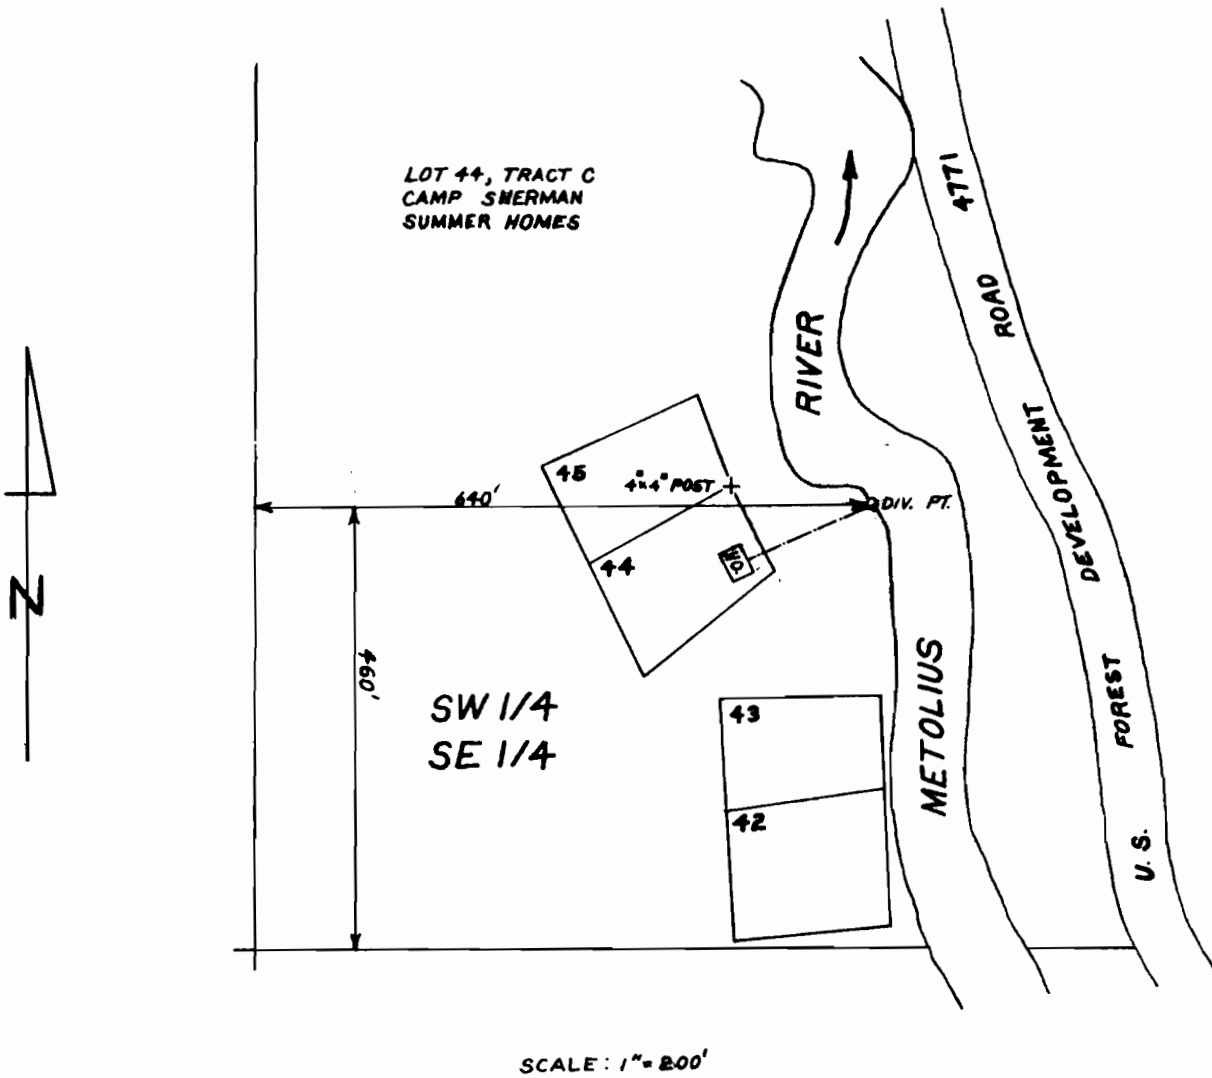

FINAL PROOF SURVEY

UNDER

Application No. 65351 Permit No. 47700

IN NAME OF

KAY L. & LUCILE N. KELLEY

Surveyed FEB. 28 19 85, by LESLIE OLSON