


T. 34 S., R. 6 W., W.M.

Sec. 13

SE 1/4 NE 1/4

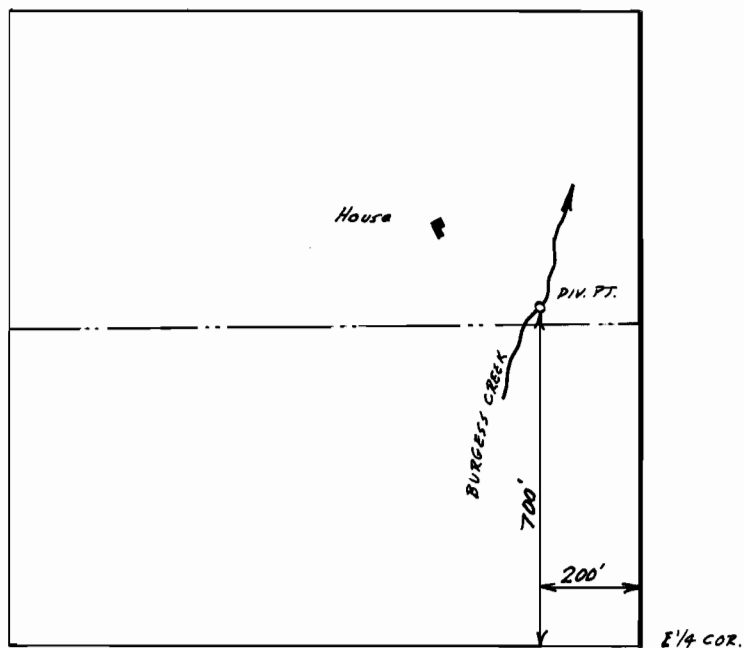

Scale 1" = 400'

**FINAL PROOF SURVEY**  
UNDER

Application No. 65149... Permit No. 47824  
IN NAME OF

DARIO A. SCARABOSIO

Surveyed Sept. 18... 1984., by J.R. WOODROOF.