


T. 13 S., R. 9 E., W. M.
SECTION 15

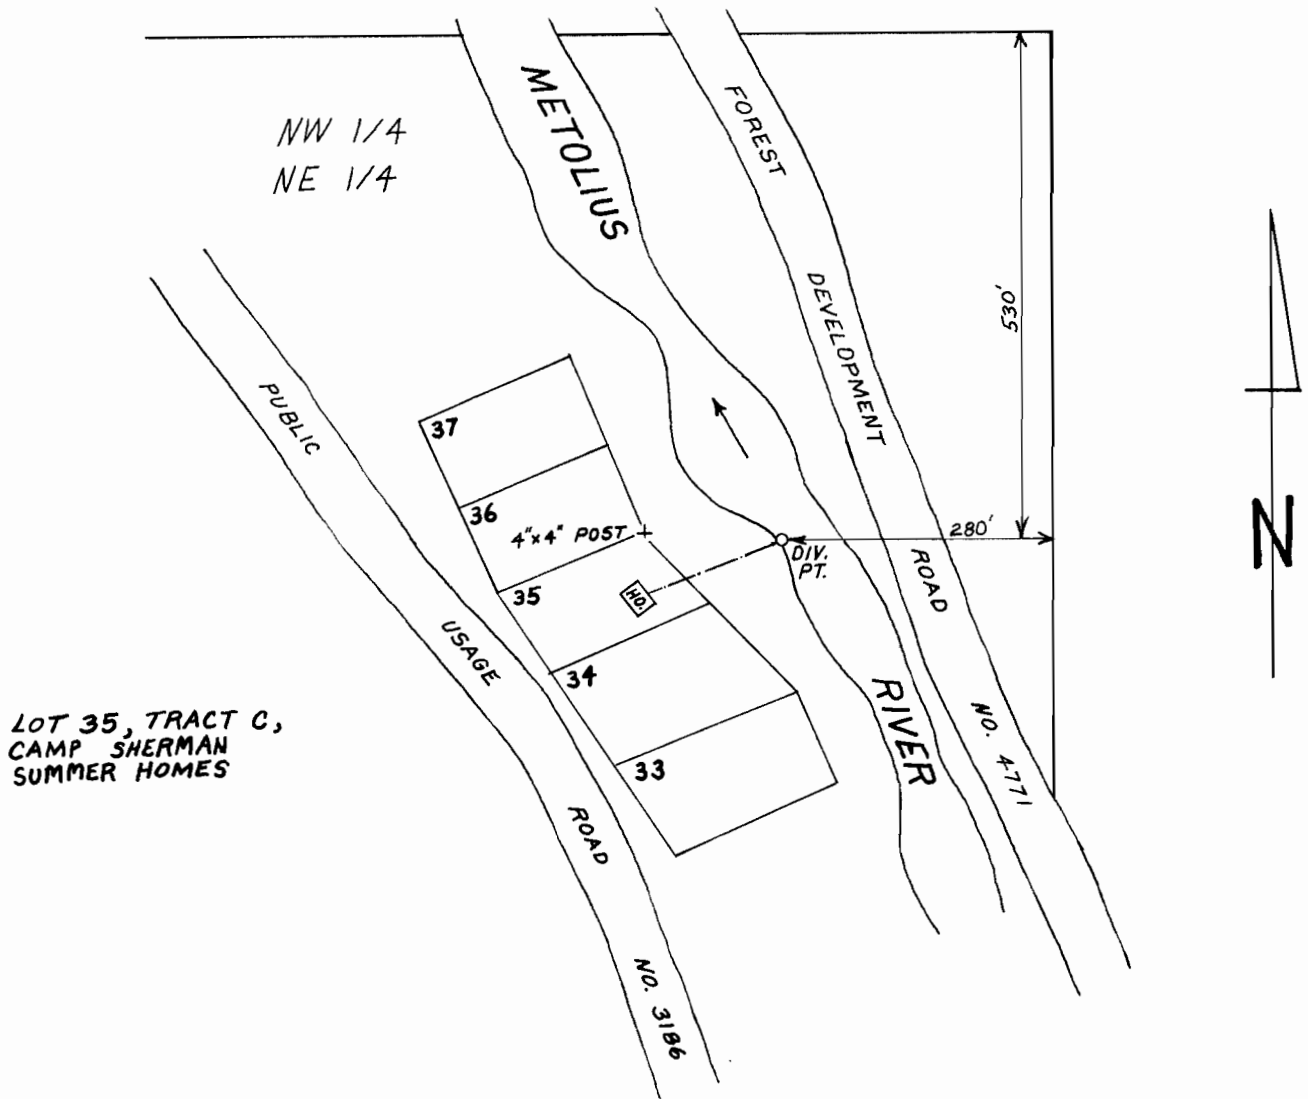

LOT 35, TRACT C,
CAMP SHERMAN
SUMMER HOMES

SCALE: 1" = 200'

FINAL PROOF SURVEY
UNDER
Application No. 65969 Permit No. 48029
IN NAME OF
JOSEPH A. PETROVICH
Surveyed FEB. 28 19 85, by LESLIE OLSON