


T.5S., R.9W., W.M.

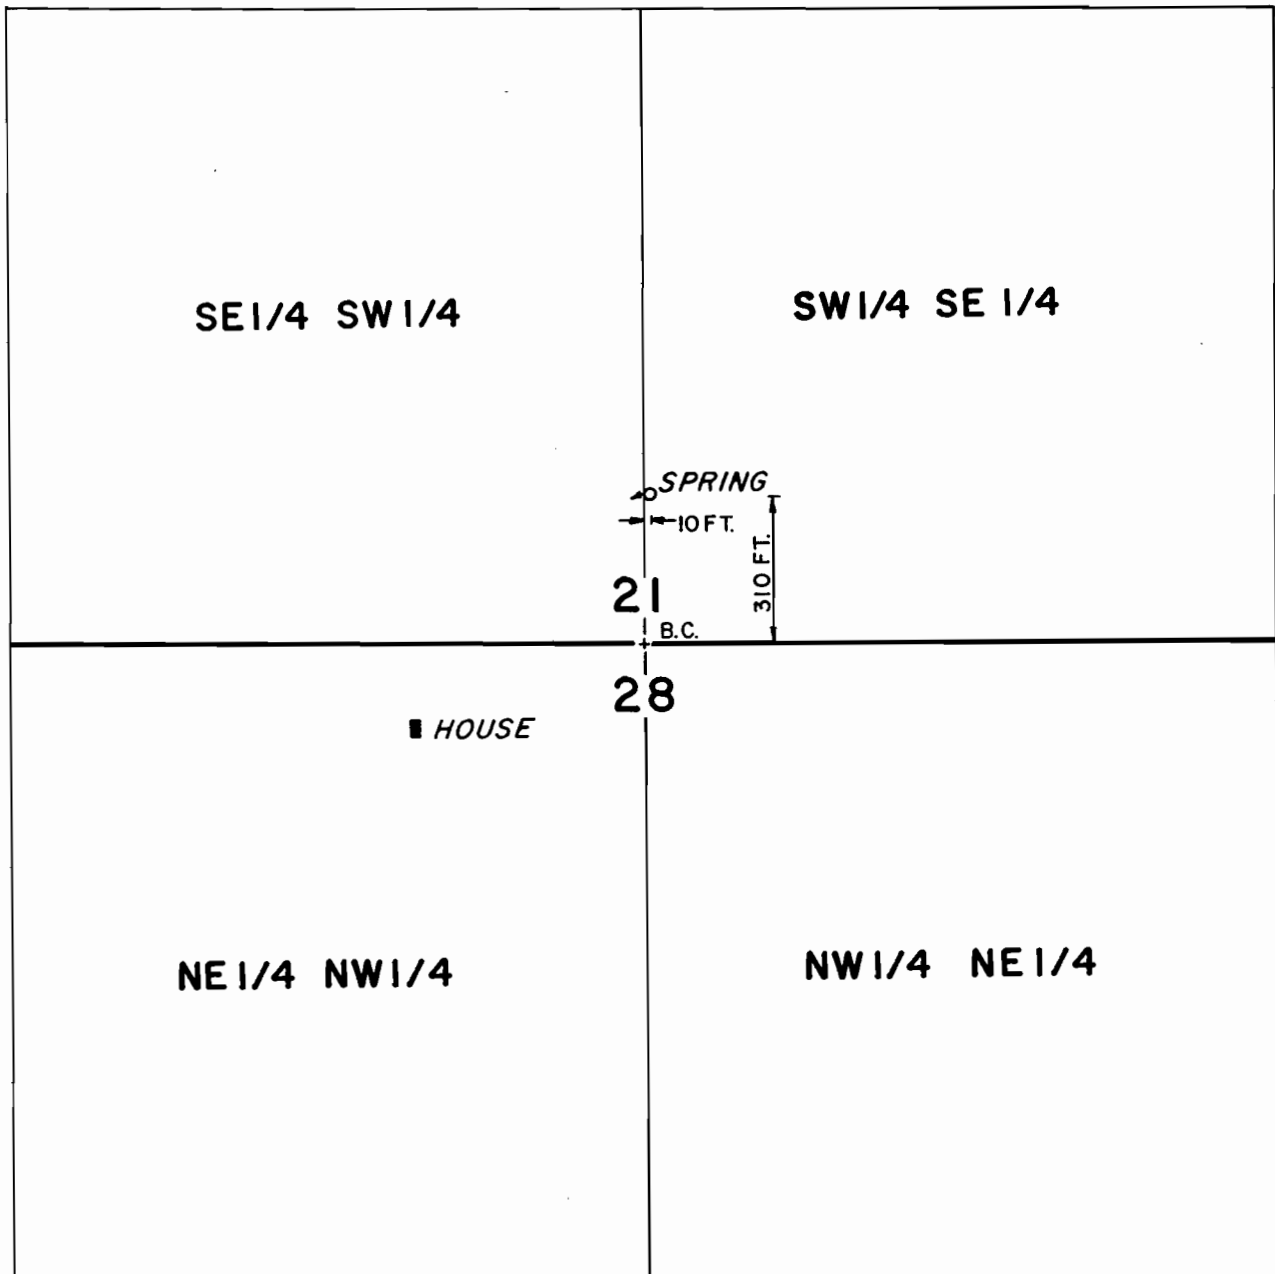

FINAL PROOF SURVEY
UNDER

Application No. 67522... Permit No. 48204.....
IN NAME OF

.....**GLENN C. MENDENHALL**.....

Surveyed SEPT. 13, 1984, by *P. Patten*.....



SCALE: 1" = 400'