


35567

T.37S. R.6W. W.M.

RECEIVED

37-6-15
JAN 25 1984
WATER RESOURCES DEPT.
SALEM, OREGON

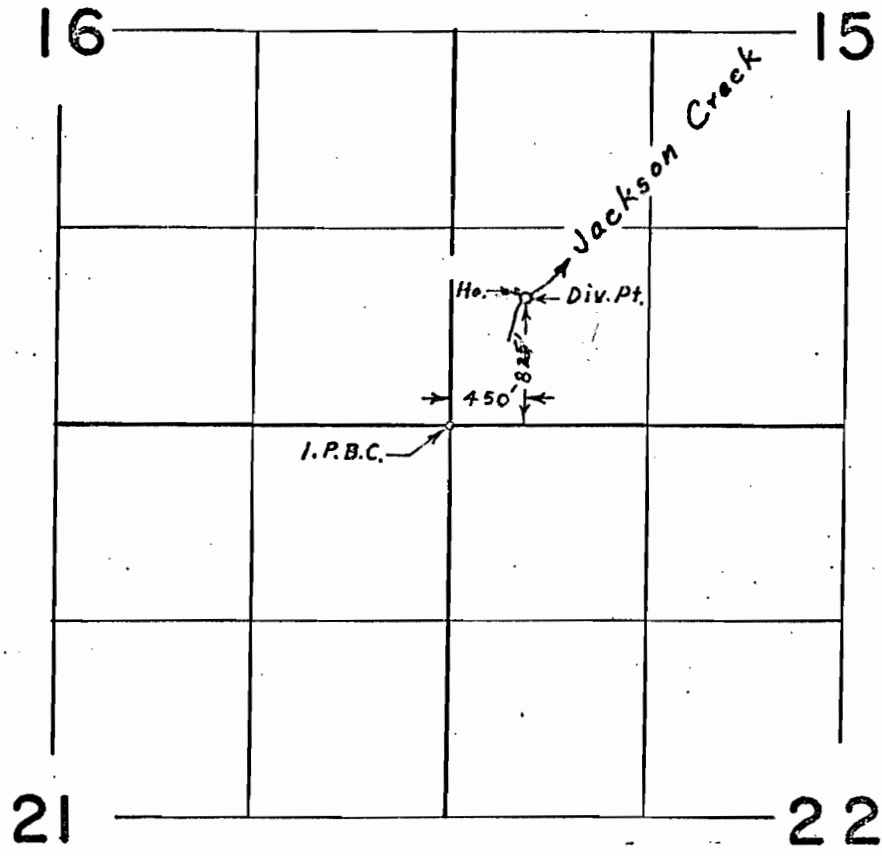

Application No. 67996

Permit No. 48287

~~FINAL PROOF SURVEY
UNDER~~

~~Application No. 47491 Permit No. 35569~~

~~IN NAME OF~~

~~VICTOR POINDEXTER~~

~~Surveyed Sept. 17, 1975, by L. E. Gould~~