


T.2N. R.11E. W.M.

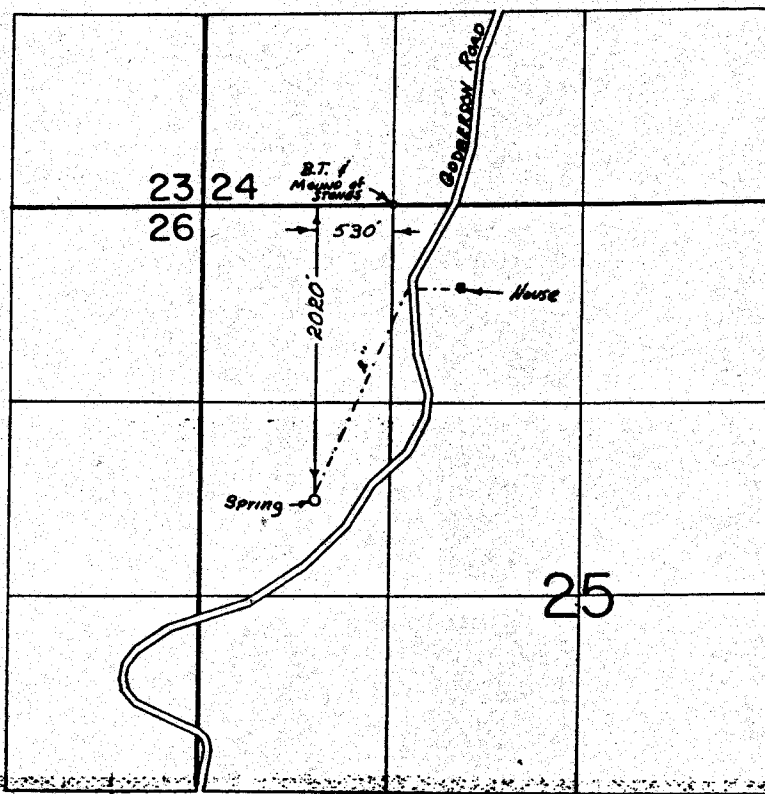

FINAL PROOF SURVEY
UNDER

Application No. 67971 Permit No. 48306
IN NAME OF

GILBERT H. WILEY

Surveyed Nov. 6 1984, by T. Paul