


T. 38 S., R. 7 W., W.M.

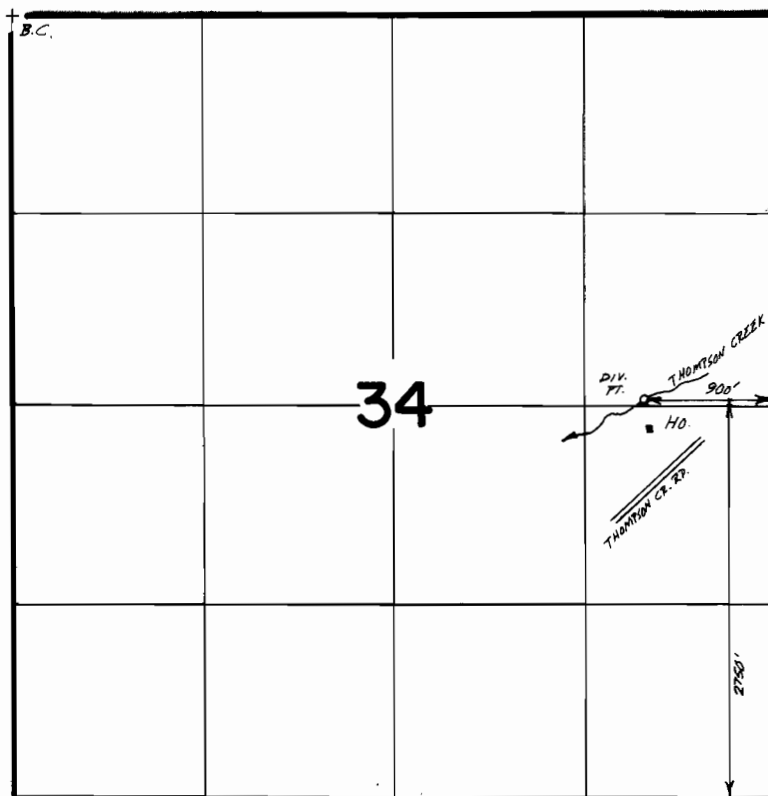

Scale 1"=1320'

FINAL PROOF SURVEY
UNDER

Application No. 68230 Permit No. 49190
IN NAME OF

BONNIE JEAN GABEL

Surveyed June 4, 1986, by B.S. JAMES