


ADDN TO FILE

T.16S.R. 4E.W.M.

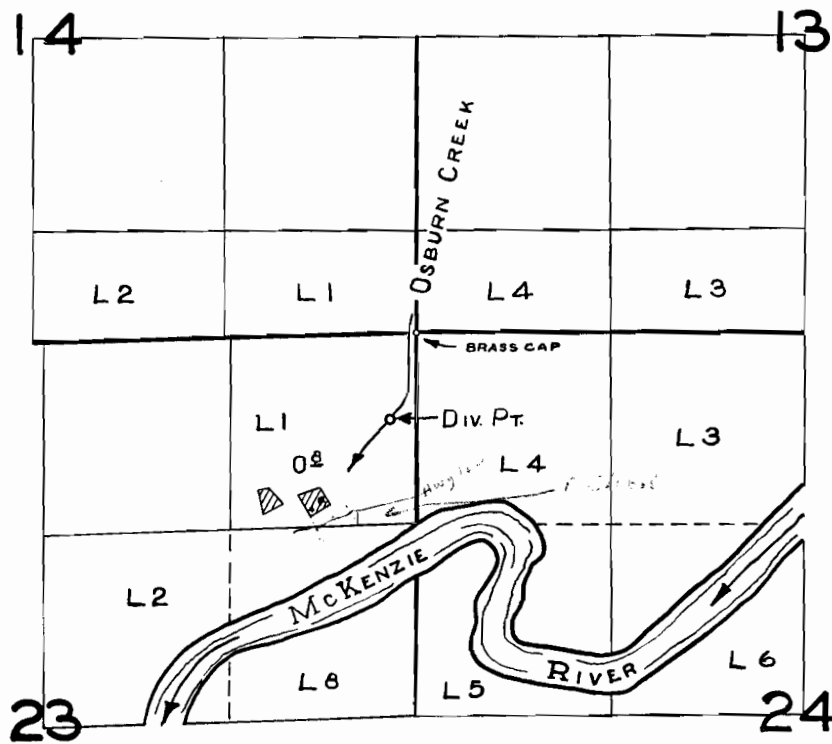

FINAL PROOF SURVEY  
UNDER

Application No. 32528. Permit No. 25694.  
IN NAME OF

ROY O. & MERNA M. SEAL


Surveyed JULY 11, 1961, by C.O. BARTELS.

Section 23 T.16 S. R. 4 E.W.M.

LANE COUNTY

1"=400'

16 45 23

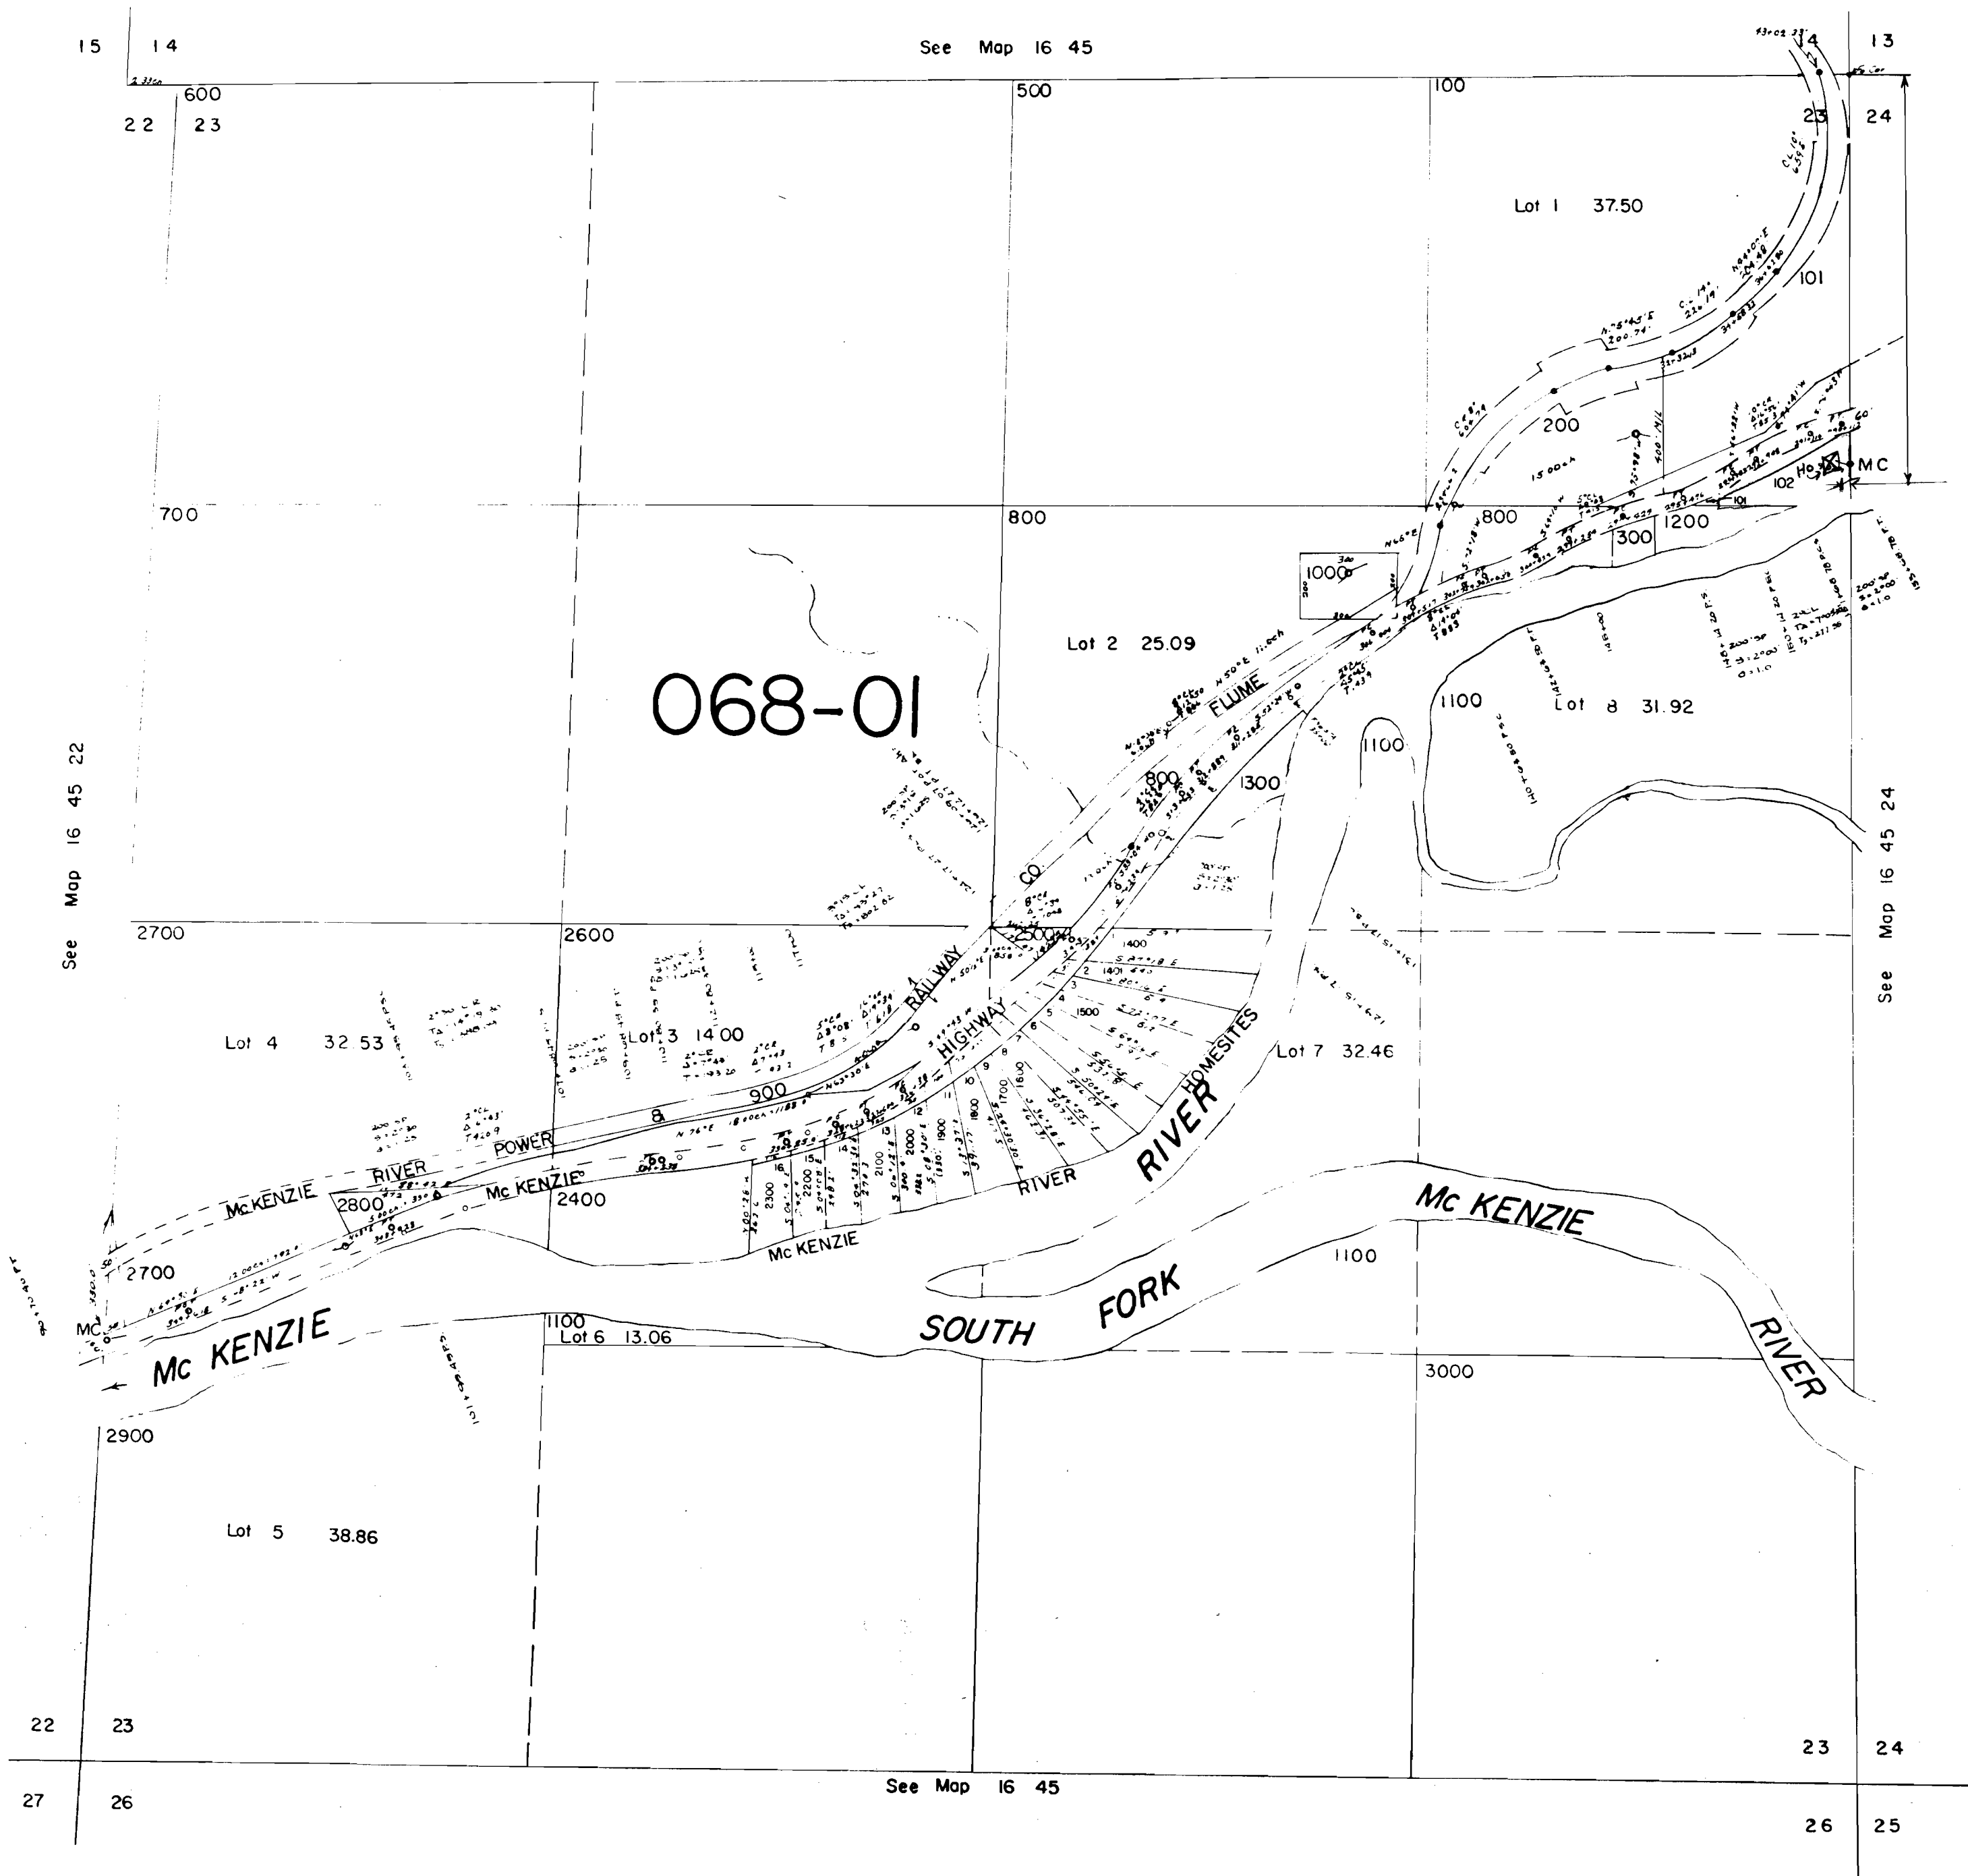

Application No. 68769  
Permit No. 49768