


T. 40 S., R. 8 W., W. M.

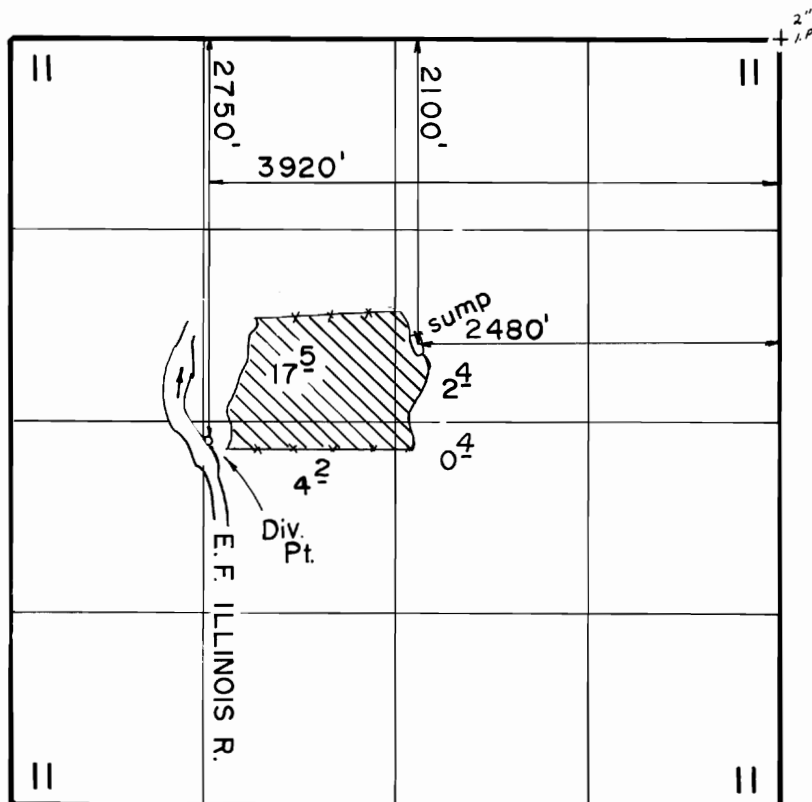

Scale: 1" = 1320'

FINAL PROOF SURVEY

UNDER

TRANSFER NO. 4216

Application No. G-9002 Permit No. G-8435.
IN NAME OF

CONRAD & GWENDOLYN SCHUBKEGEL

Surveyed APR. 16. 1986, by B. S. JAMES.