


RECEIVED

19 1931

WATER RESOURCES DEPT.
SALEM, OREGON

T. 4 S. R. 1 W. W. M.

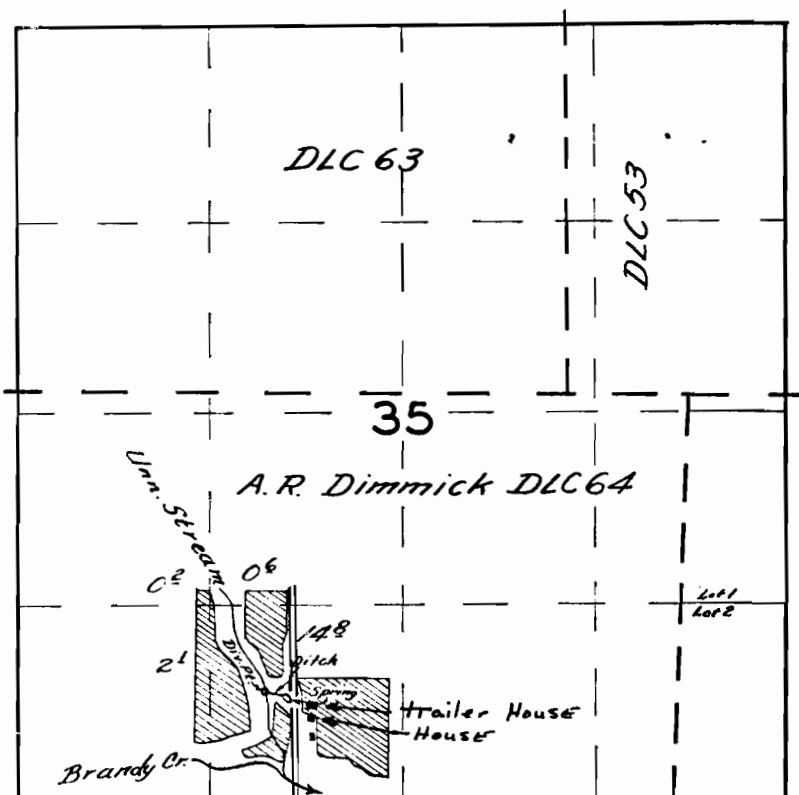

Spring Loc: 680 ft N and 1850 ft E FROM
THE SW COR SEC 35

~~FINAL PROOF SURVEY~~

UNDER

~~Application No. 24612 Permit No. 19466~~

IN NAME OF

~~A. A. MONNIER~~

~~Surveyed Sept. 19, 1956, by M. B. Dick~~

Application No. 61360

Permit No. 45610

DFR-20-79

C.P.