


T. 5S, R. 3W, W. M.

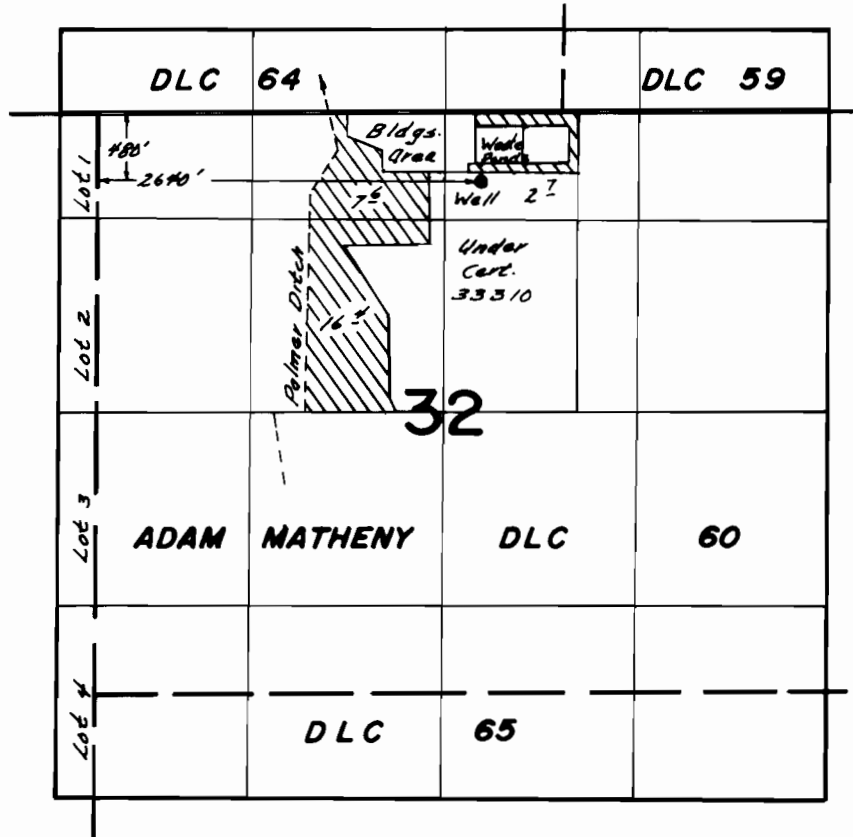

FINAL PROOF SURVEY UNDER

Application No. ~~G-5527~~ Permit No. ~~G-5413~~...
IN NAME OF

.....**PETE DE HAAN**.....

Surveyed **May...9...** 1979, by **C.R. RODRIGUEZ**