


T. 9S., R. 4W., W.M.

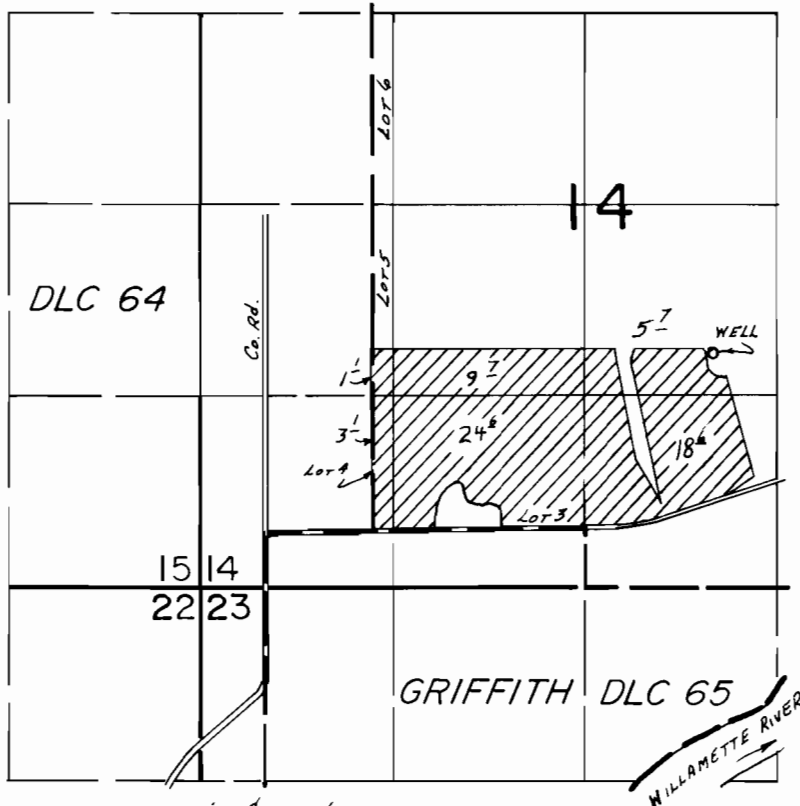

WELL LOC.: 1220' N. & 3070' E. FROM NW COR. GRIFFITH DLC 65.

FINAL PROOF SURVEY
UNDER

Application No. G-6850 Permit No. G-6336.....
IN NAME OF

SUNNY 70 FARM, INC......

Surveyed NOV. 2..... 1981., by S.C. BROWN.....