


# T.18&19S., R.46E., W.M.

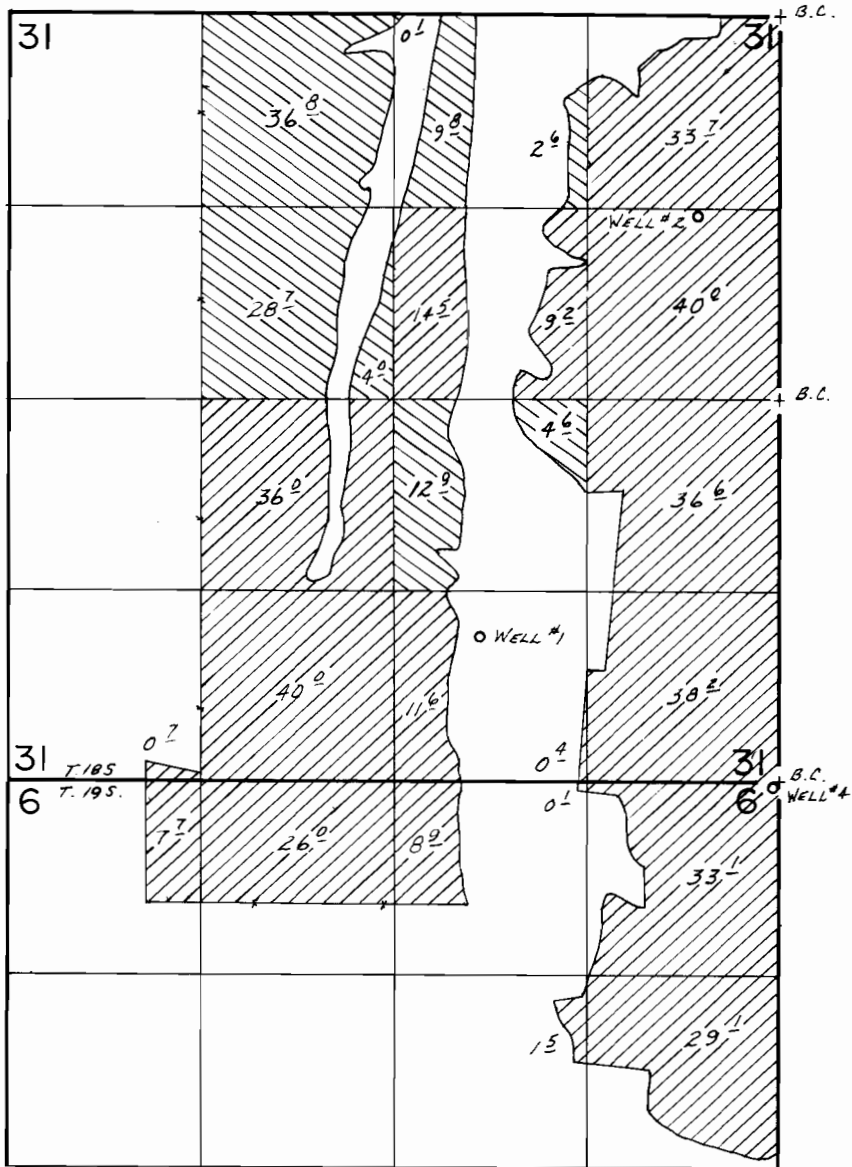

WELLS LOC.: #1. 990' N. & 2050' W., #2. 3900' N. & 550' W., #4. 40 S. & 40' W. ALL FROM SE COR. SEC. 31.

SCALE: 1" = 1320'

## FINAL PROOF SURVEY UNDER

G-6925

G-6357



Application No. G-8471.. Permit No. G-7637.....



IN NAME OF

.....BETTY LEE WENDT.....

Surveyed Mar. 5..... 1986, by L.M. TOLL.....