


T. 11 S., R. 2 W., W.M.

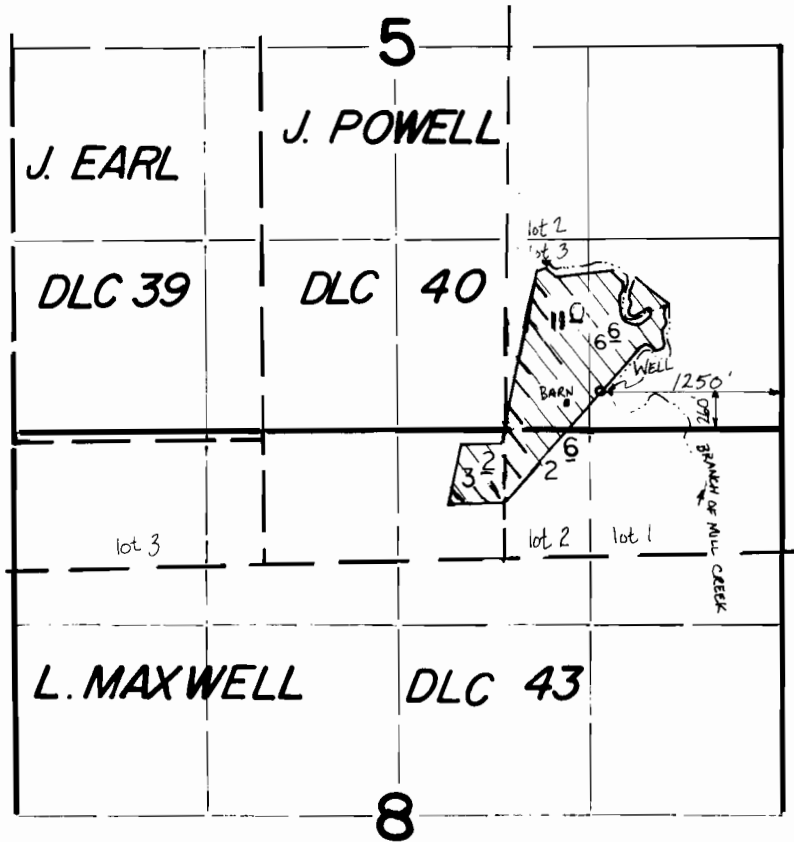

FINAL PROOF SURVEY
UNDER

Application No. ..G..7355 Permit No. ..G..681Q.....
IN NAME OF

WILBERT H. BILYEU

Surveyed OCT. 21, 1983, by ..M. CAHILL.....