


T.39S., R.3W., W.M.

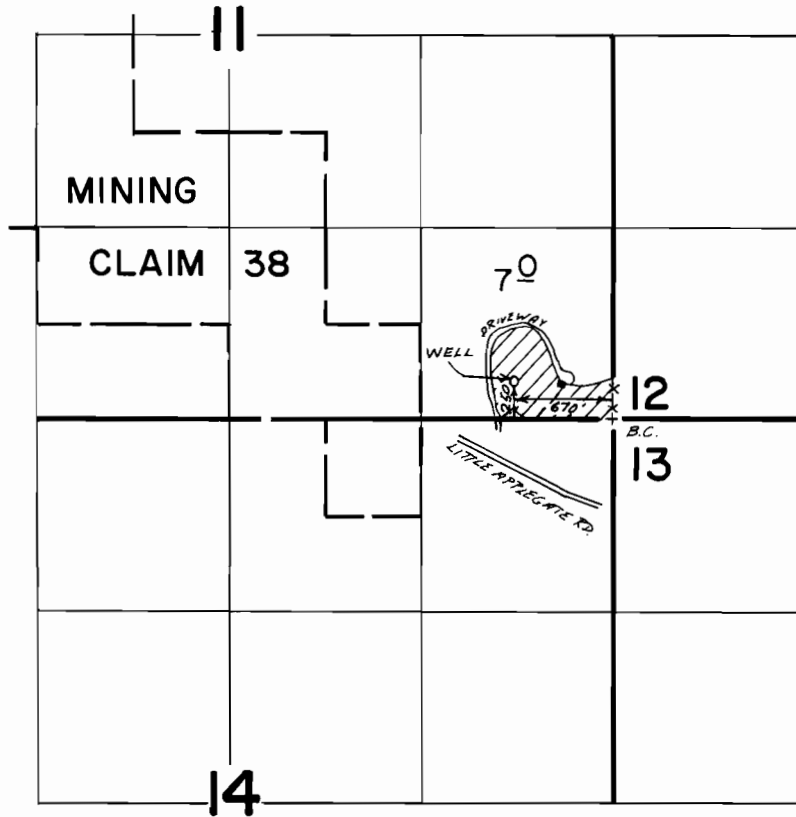

Scale 1"=1320'

FINAL PROOF SURVEY UNDER

Application No. G-7458 Permit No. G-6950....
IN NAME OF

..... MARY H. KELEMAN

Surveyed Nov. 24, 1987, by B.S. JAMES.....