
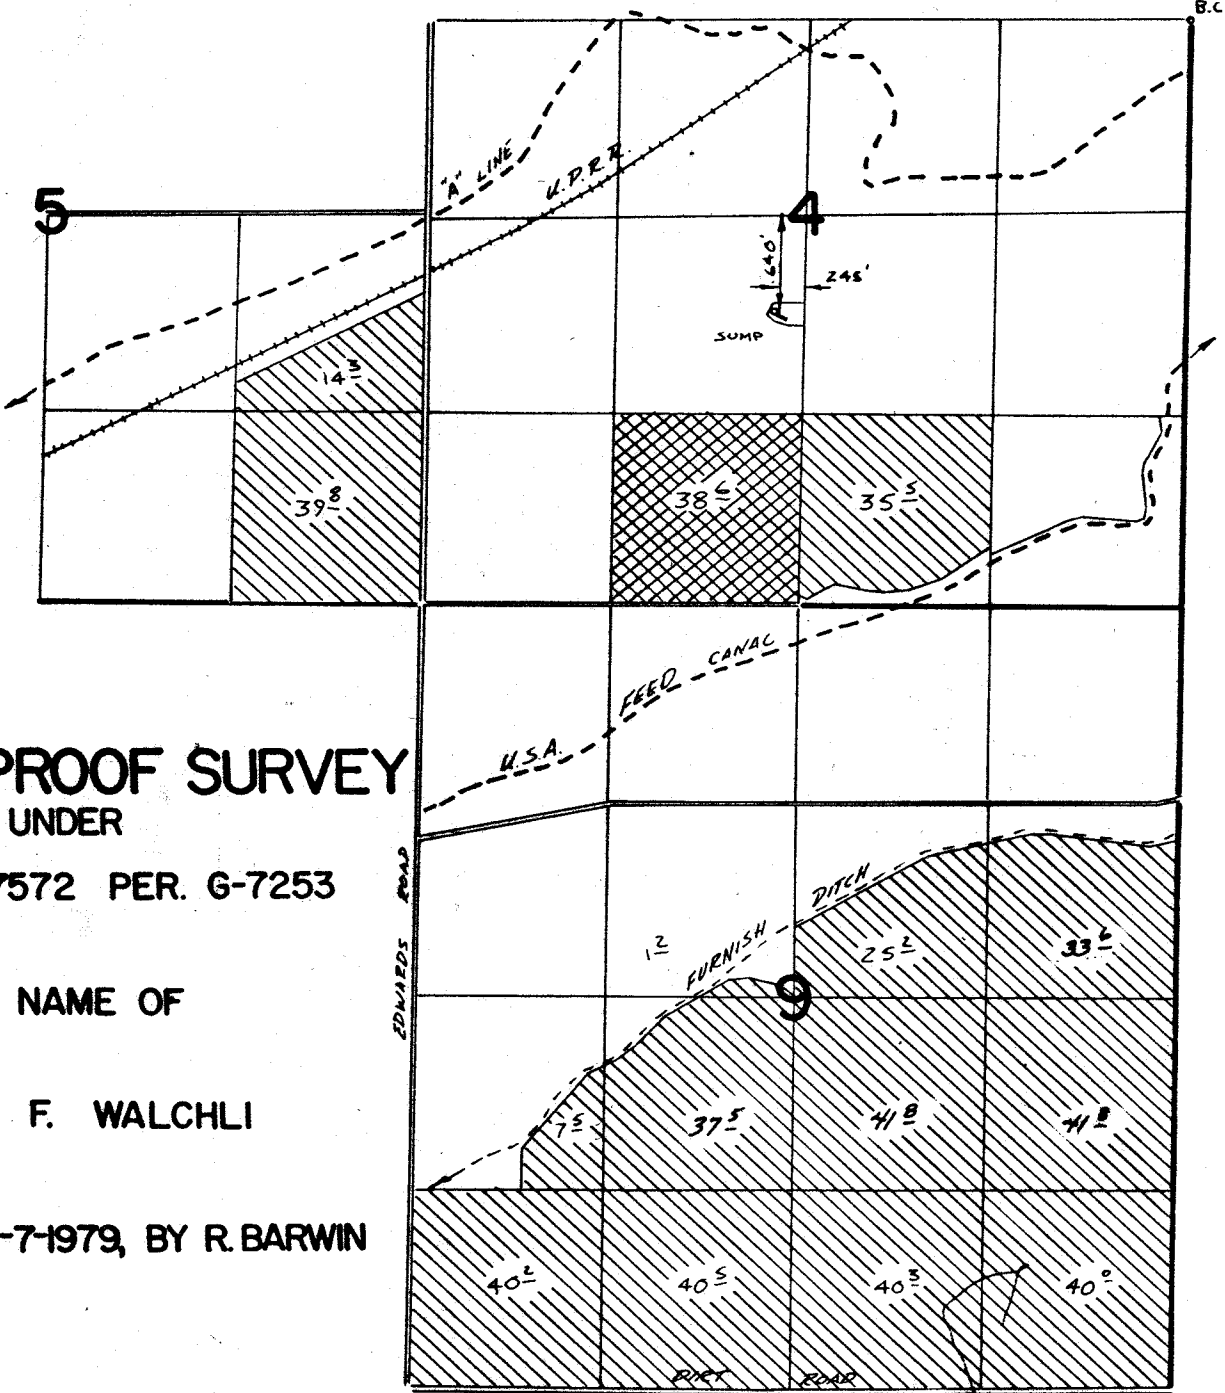


G-7253 58959

T.4N., R.29E., W.M.

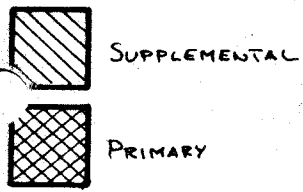

FINAL PROOF SURVEY UNDER

APPL. G-7572 PER. G-7253

IN NAME OF

JOHN F. WALCHLI

SURVEYED 2-7-1979, BY R. BARWIN