


T. 4N., R. 29E., W. M.

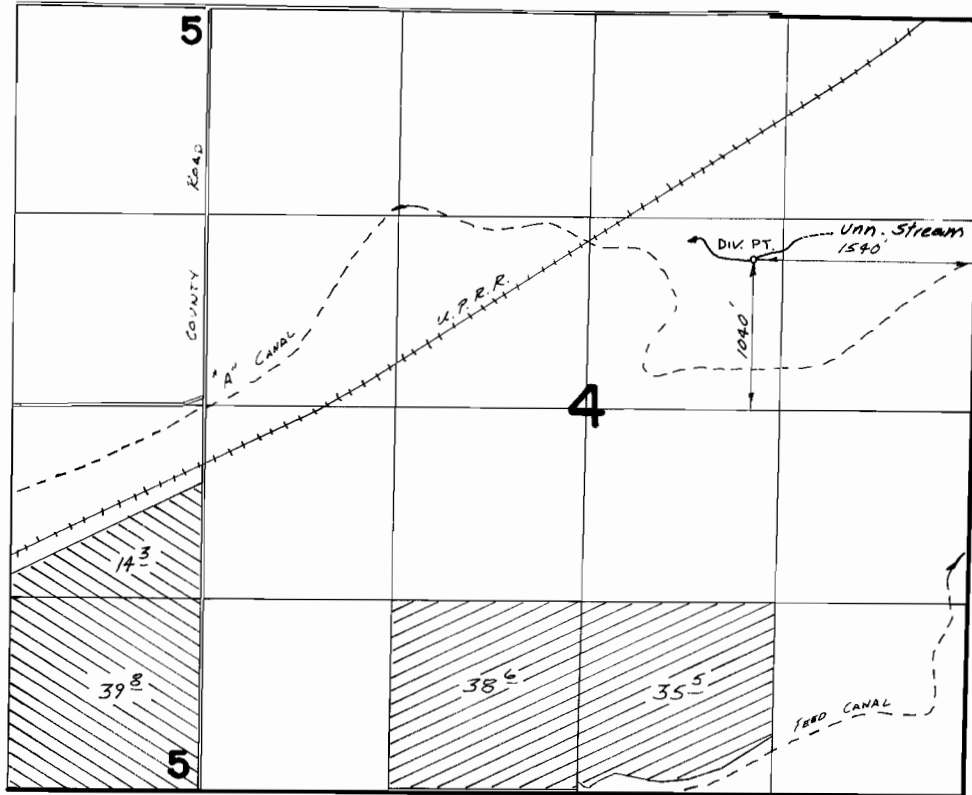

PRIMARY



SUPPLEMENTAL

FINAL PROOF SURVEY
UNDER

Application No. **54932** Permit No. **41515**.....
IN NAME OF

.....**JOHN F. WALCHLI**.....

Surveyed Feb. 24..... 1982., by V.L. Church.....