T.4N., R.29E., W.M.

Div. Pt. Loc: 1180'S. & 580'W. From NE Cor. Sec. 4
Div. Pt. 1 Loc: 1040'N. & 1540'W. From E¼ Cor. Sec. 4

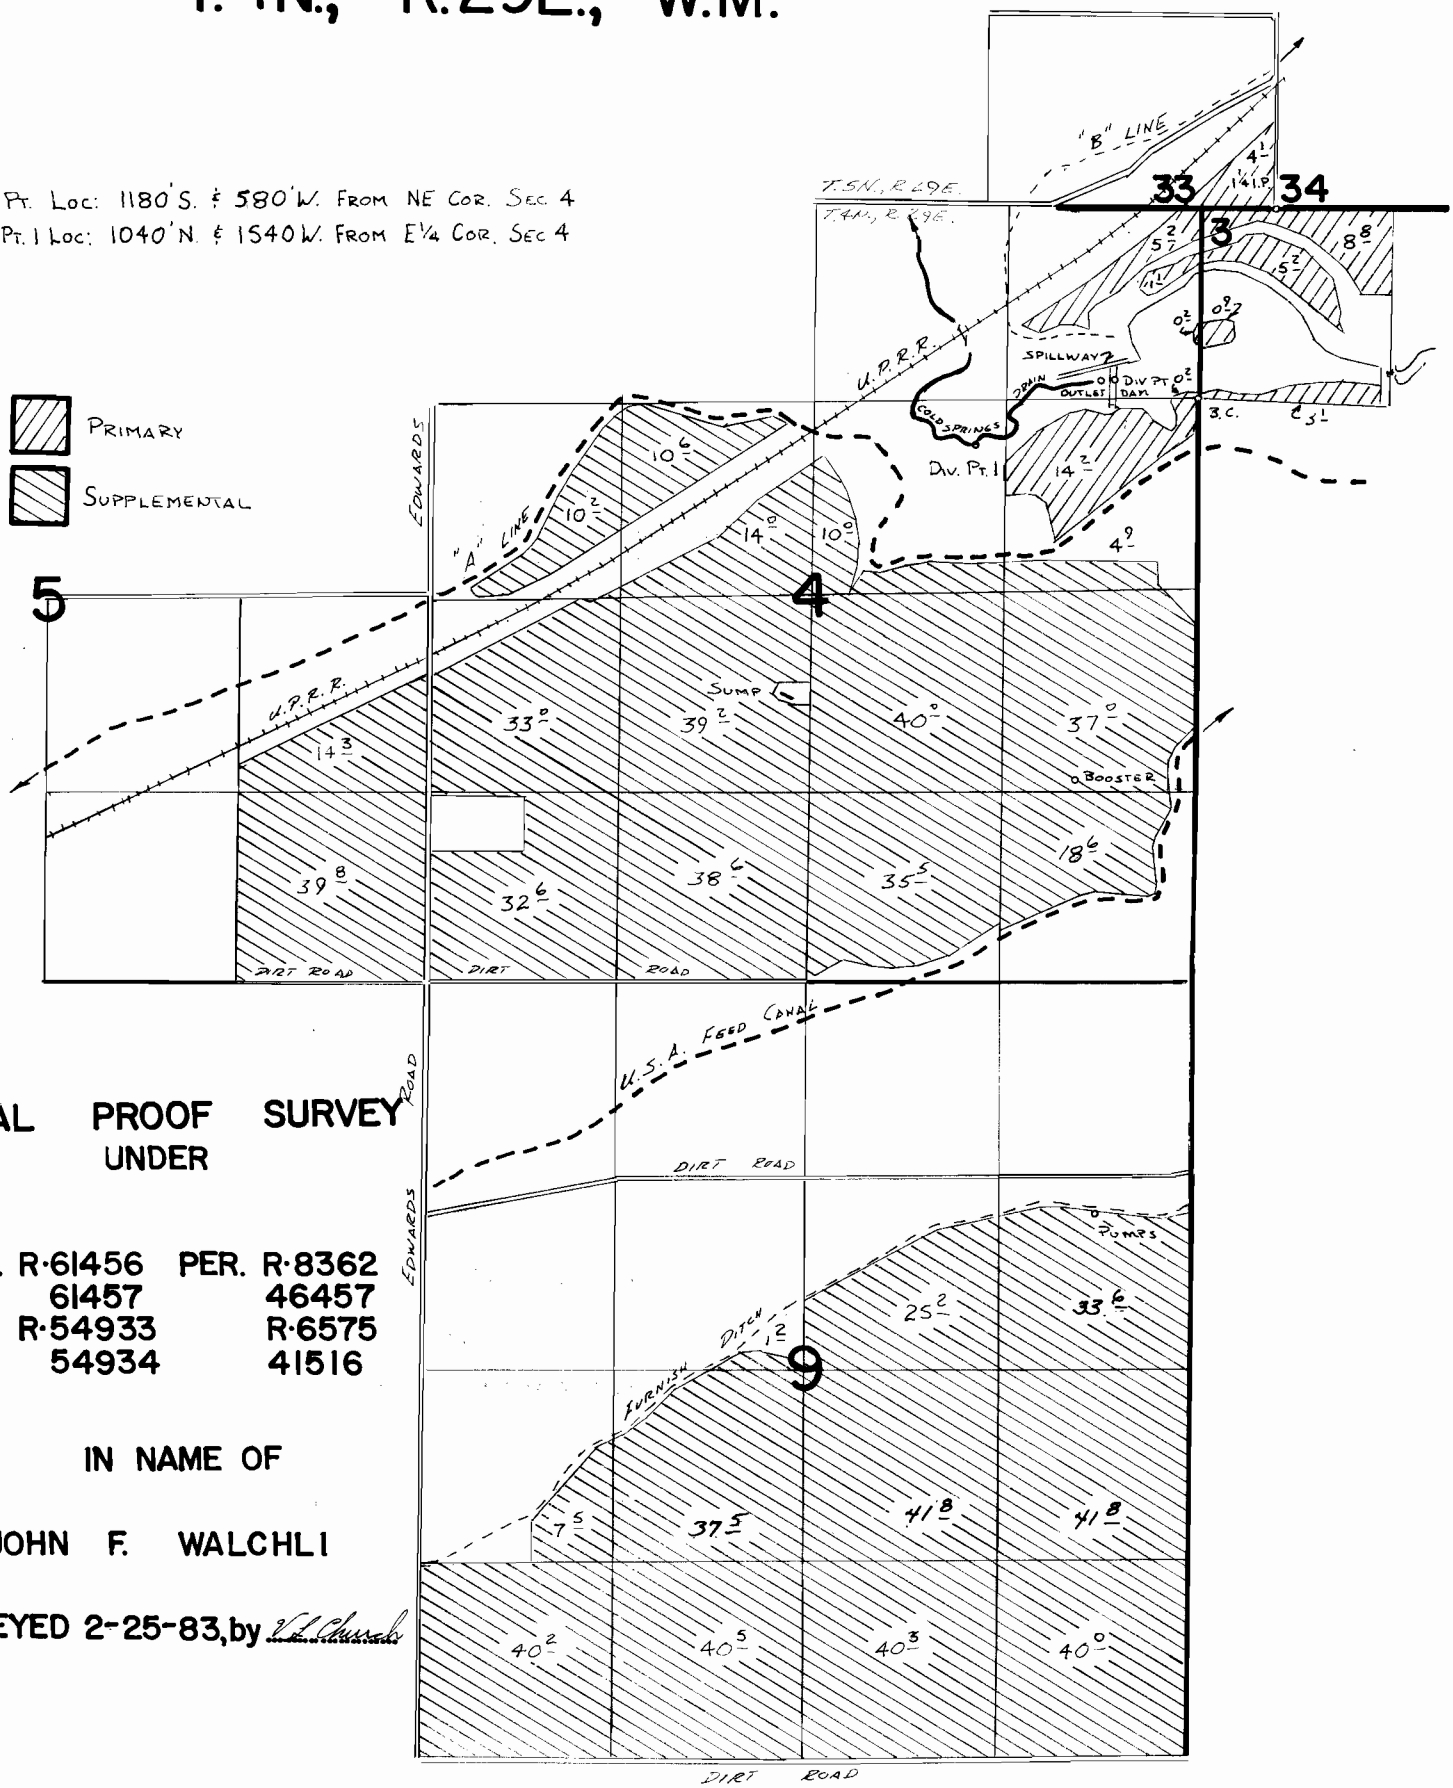

FINAL PROOF SURVEY
UNDER

APPL.	PER.
R-61456	R-8362
61457	46457
R-54933	R-6575
54934	41516

IN NAME OF

JOHN F. WALCHLI

SURVEYED 2-25-83, by V. L. Church

3-11-83

6-20 89R