


T.4N., R.28E., W. M.

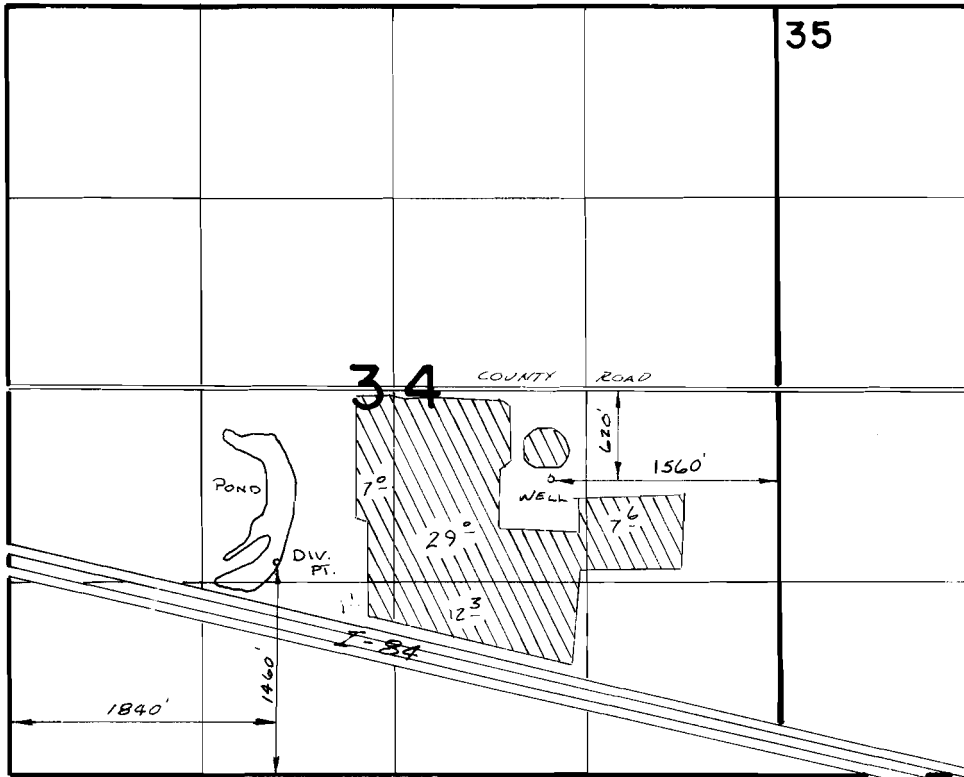

FINAL PROOF SURVEY
UNDER

53080 42204
Application No. **G:8236** Permit No. **G:7614**.....
IN NAME OF

.....**DOUBLE M. RANCH**.....

Surveyed *Feb. 25* 19*83*, by *W. H. Church*.....