
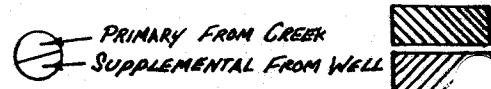


T.3S. R.13E. W.M.

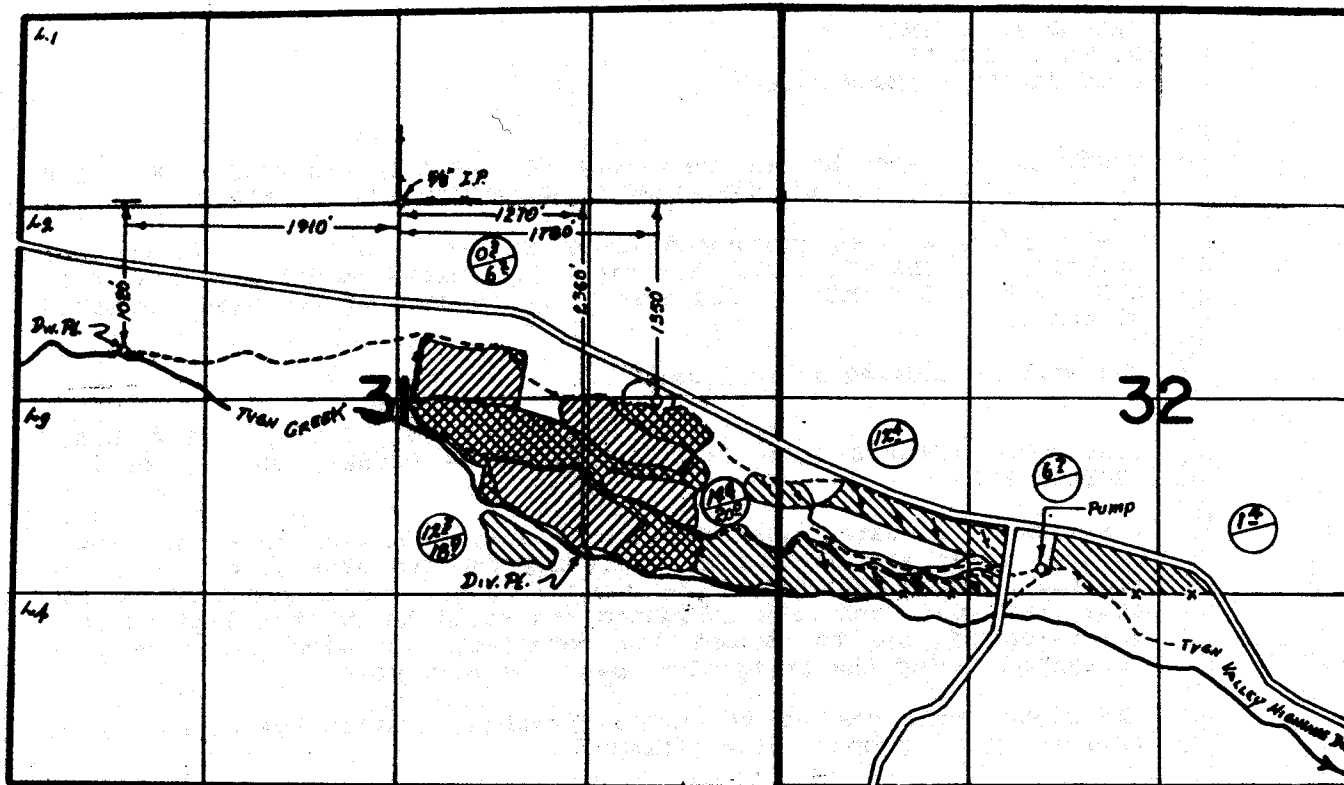

FINAL PROOF SURVEY UNDER

Application No. G-8240 Permit No. G-7740
56132 42415
IN NAME OF

GERALD H. HAUSER

Surveyed May 11, 1983, by T. J. Paul