


T.19S.,R.47E.,W.M.

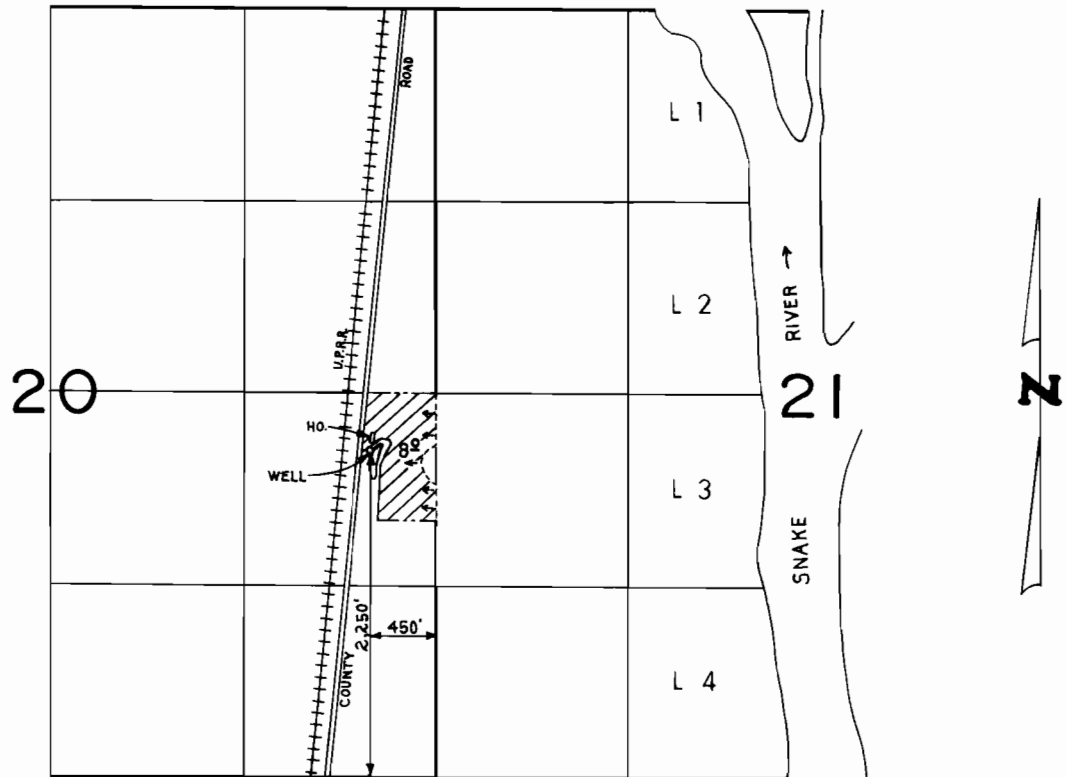

1" = 1,320'

**FINAL PROOF SURVEY**  
UNDER

Application No. G-8408.... Permit No. G-7759.....  
IN NAME OF

.....**BELVEAL, CHARLES P.**.....

Surveyed FEB...27.. 1986.., by L.M.TOLL.....