


# T. 27S., R. 7W., W.M.

SEC. 32

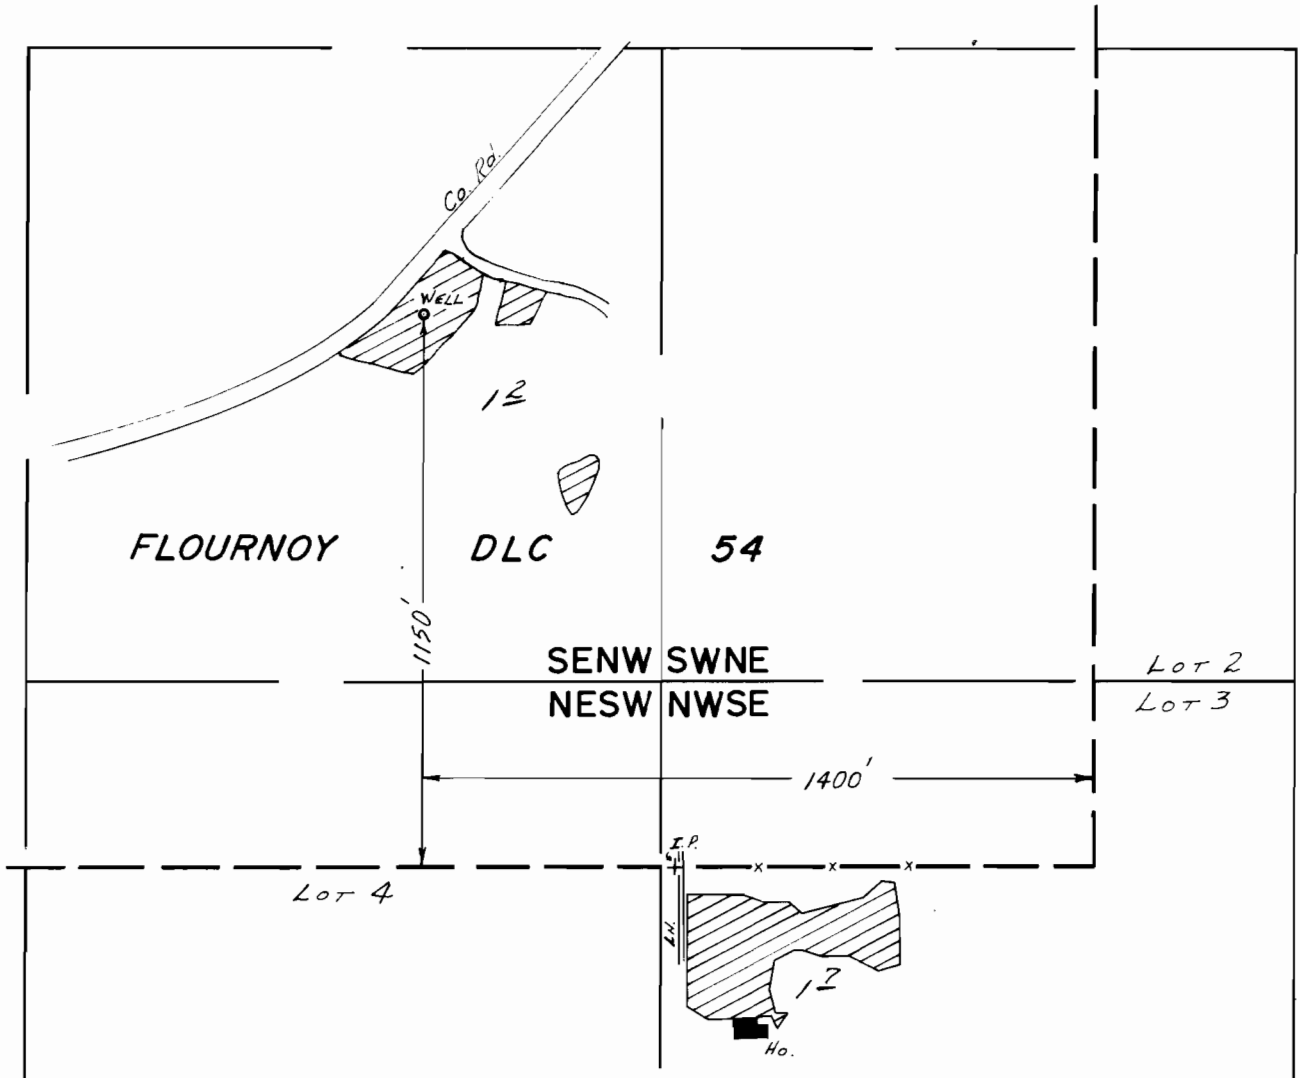

SCALE: 1" = 400'

## FINAL PROOF SURVEY UNDER

Application No. G-8254 Permit No. G-7860  
IN NAME OF

ALBERT POWELL

Surveyed JUNE 23, 1982, by L.M.TOLL