


T.2N. R.15E. W.M.

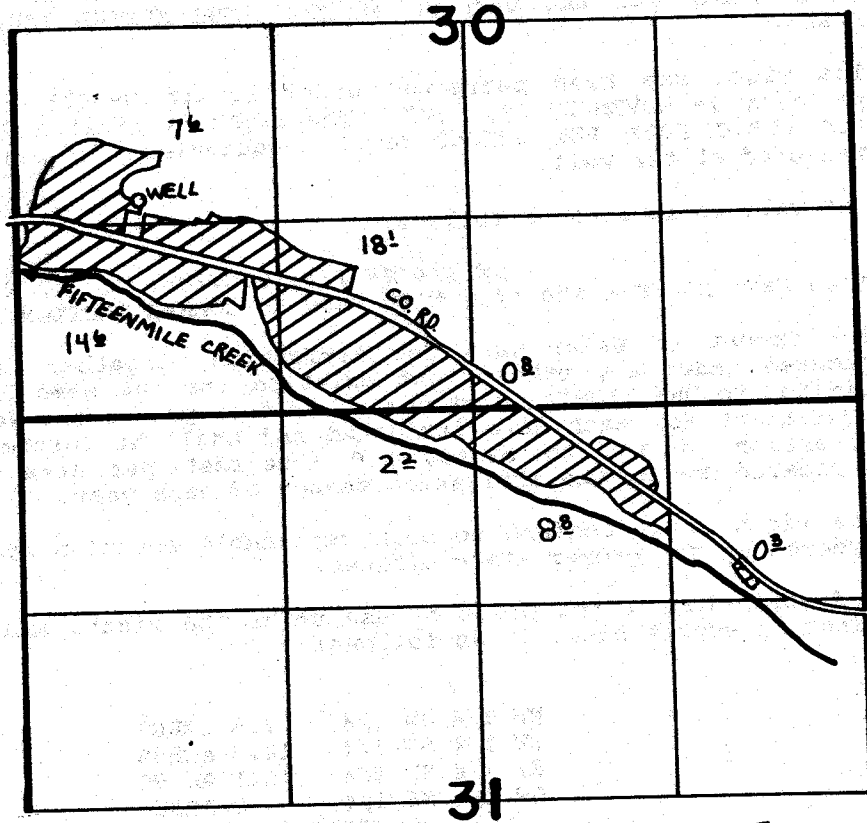

WELL LOC. - 1440' N. & 850' E. FROM S.W. CORNER SEC. 30

**FINAL PROOF SURVEY**  
UNDER

Application No. G-8549. Permit No. G-7871.....  
IN NAME OF

**QUIRK PROPERTIES**

Surveyed June 25, 1979, by C.L. Hughes.....