


T.26S.,R.16E.,W.M.

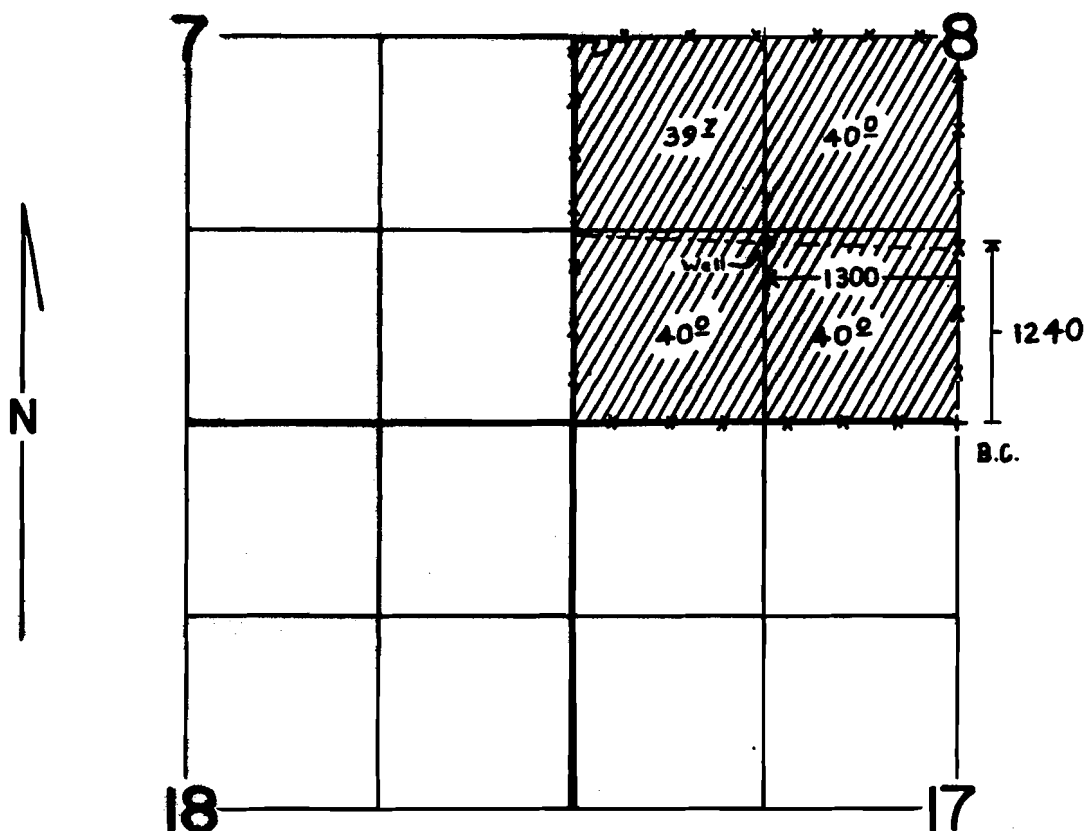

SCALE: 1" = 1320'

FINAL PROOF SURVEY
UNDER

Application No. G-5577 Permit No. G-7886

IN NAME OF

JAMES P. McCAIN

Surveyed ~~MM~~ 14 1985, by LESLIE OLSON