


# T.5S.,R.2W.,W.M.

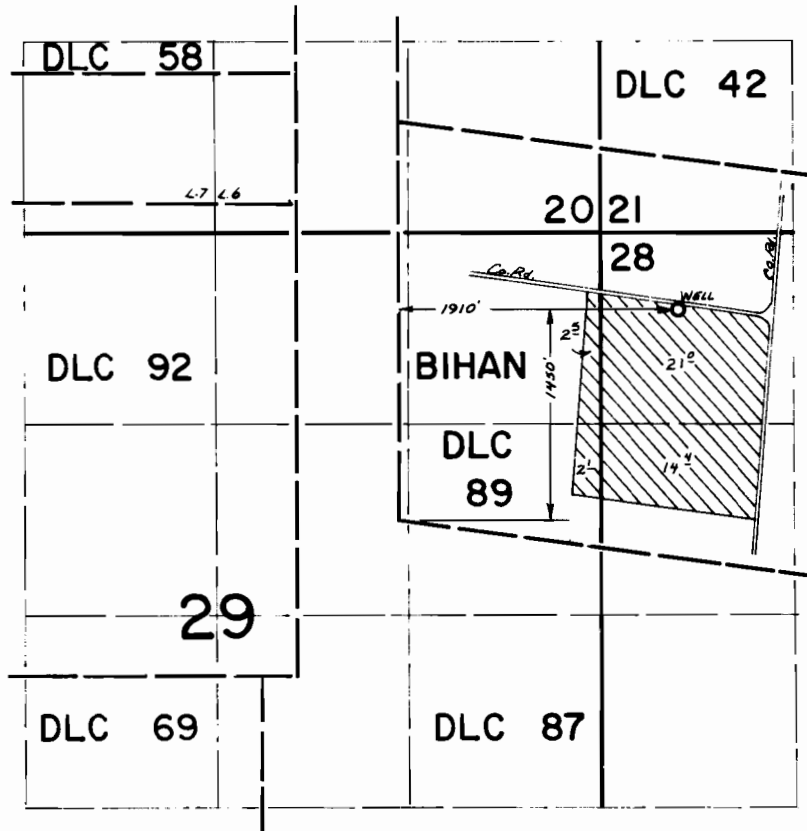

## FINAL PROOF SURVEY UNDER

Application No. G:8740 Permit No. G:8167.....  
IN NAME OF

.....**WILBUR LEUTWYLER**.....

Surveyed Oct. 14, 1981, by S.C. BROWN.....