
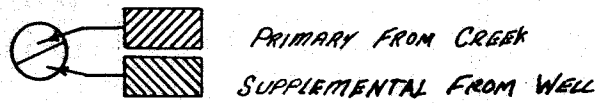


# T.18&2N. R.15E. W.M.

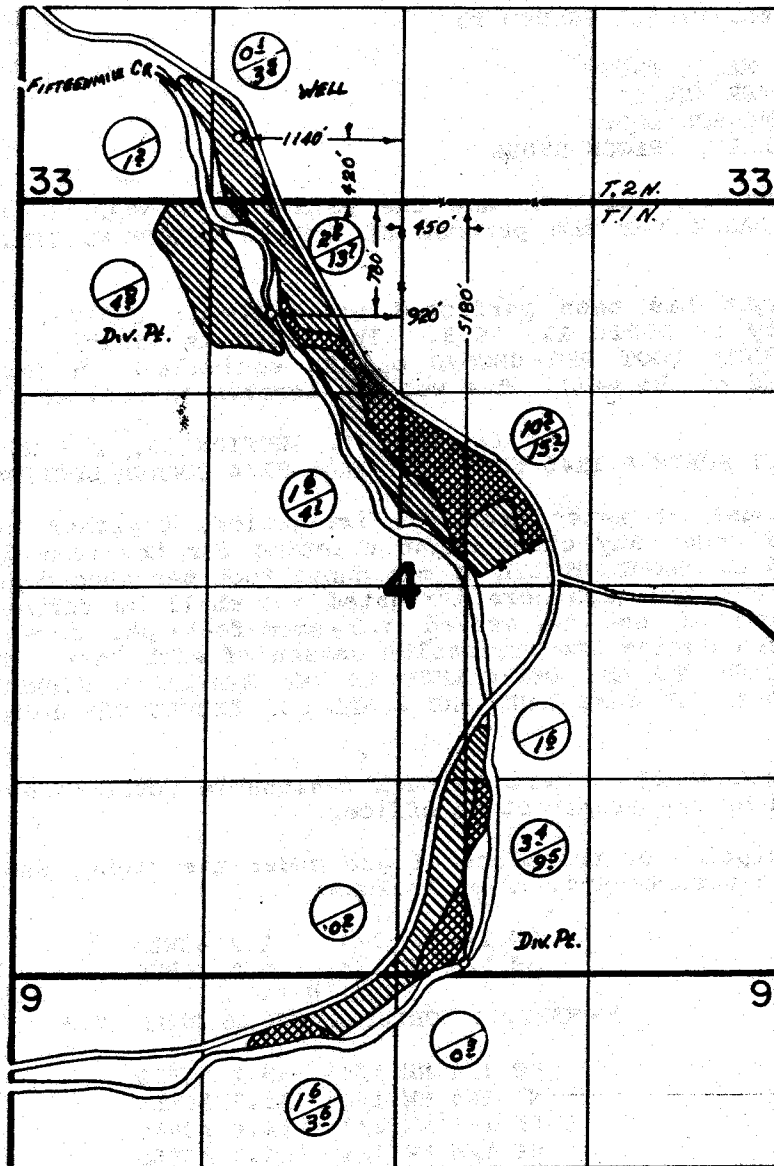

## FINAL PROOF SURVEY UNDER

Application No. 57290 Permit No. 46963  
G-8733 G-8177  
IN NAME OF

R. H. L. KELLY TRUST % PETER E. KELLY

Surveyed May 20 1983, by T. J. Paul