


T. 36 S., R. 7 W., W.M.

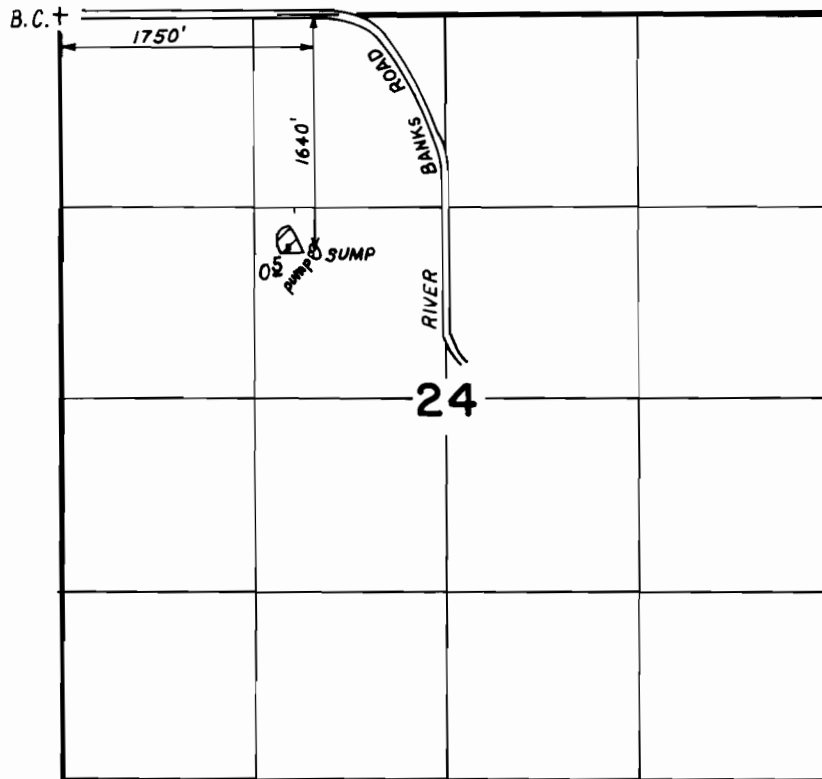

Scale: 4" = 1 mile

FINAL PROOF SURVEY
UNDER

Application No. G-8828 Permit No. G-8208
IN NAME OF

MAY KENYON

Surveyed JAN. 19 1984, by B. S. JAMES