


T.8S., R.39E., W.M.

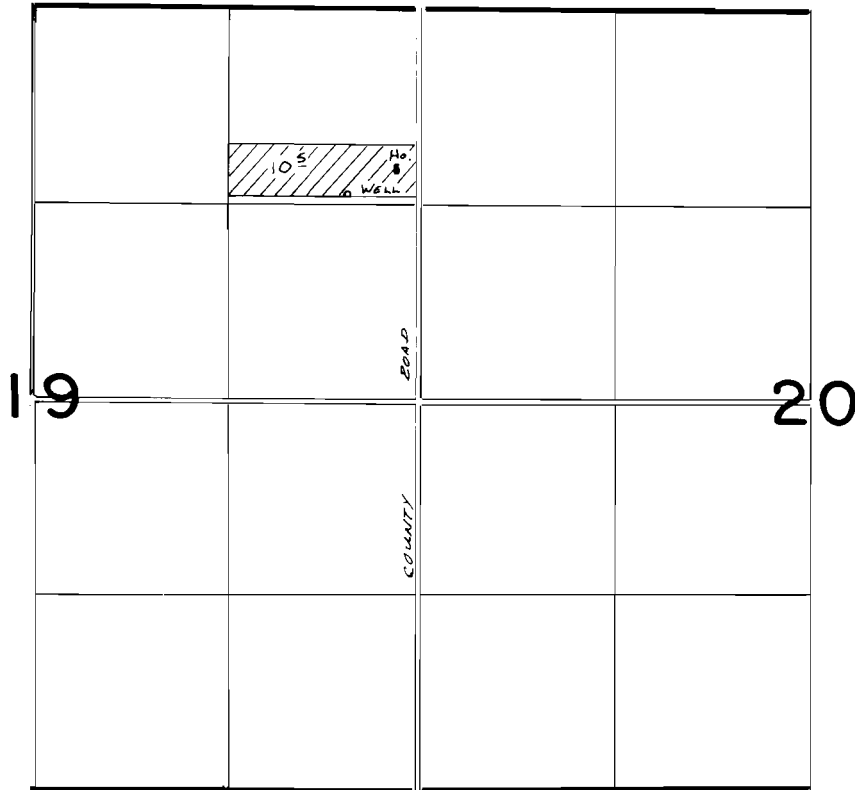

WELL LOCATION 1410' N. & 500' W. FROM E 1/4 COR. SEC 19

FINAL PROOF SURVEY
UNDER

Application No. **G:8846** Permit No. **G:8239**

IN NAME OF

DARALD W. DOUD

Surveyed *July 15* 19*82*, by *V.H. Church*