


T. 38S., R. 19E., W.M.

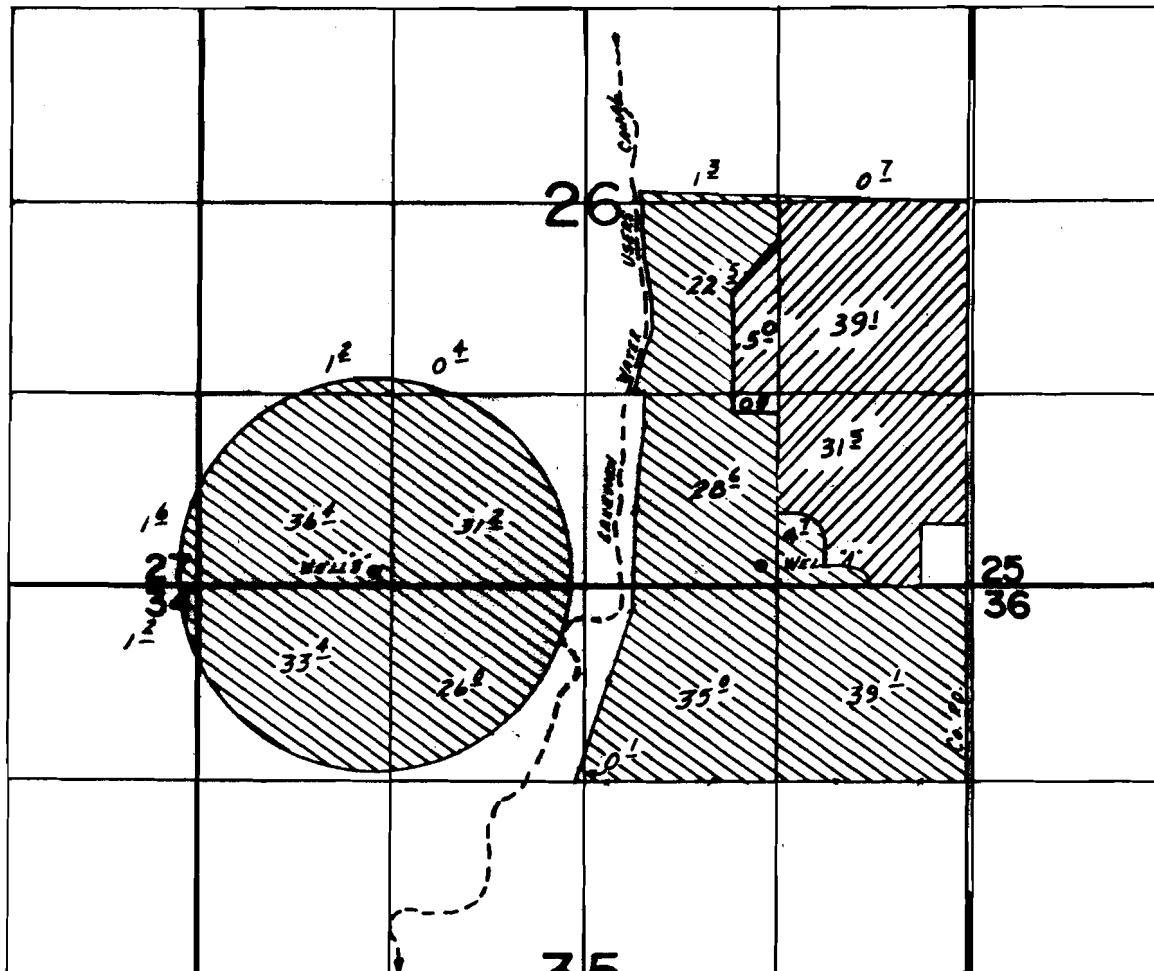

WELLS LOC: WELL "A" - 100' N. & 100' W., WELL "B" - 100' N. & 40' W., BOTH FROM SE COR. SEC. 26.

SCALE: 1" = 1320'

FINAL PROOF SURVEY UNDER

G-8842 G-8250 
 Application No. G-9472. Permit No. G-8882... 
 IN NAME OF

..... C. F. ENLOE

Surveyed June 21, 1984, by B.W. BISHOP.....