


T.6S., R.1W.,W.M.

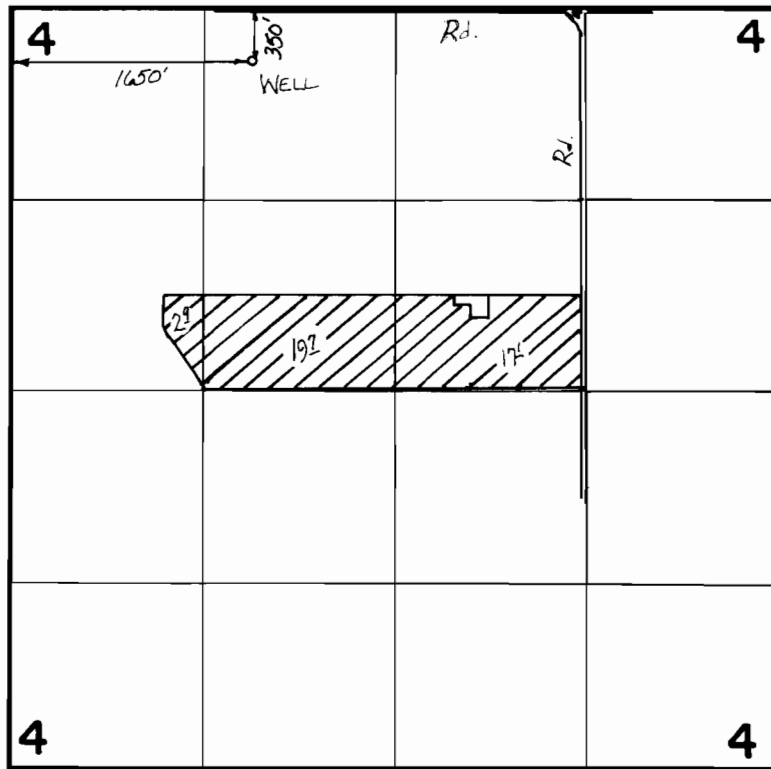

FINAL PROOF SURVEY UNDER

Application No. G.8881... Permit No. G.8279.....
IN NAME OF

RAYMOND GRIESEN AUER

Surveyed NOV. 18, 1983, by M. CAHILL.....