


# T.6S., R.2W., W.M.

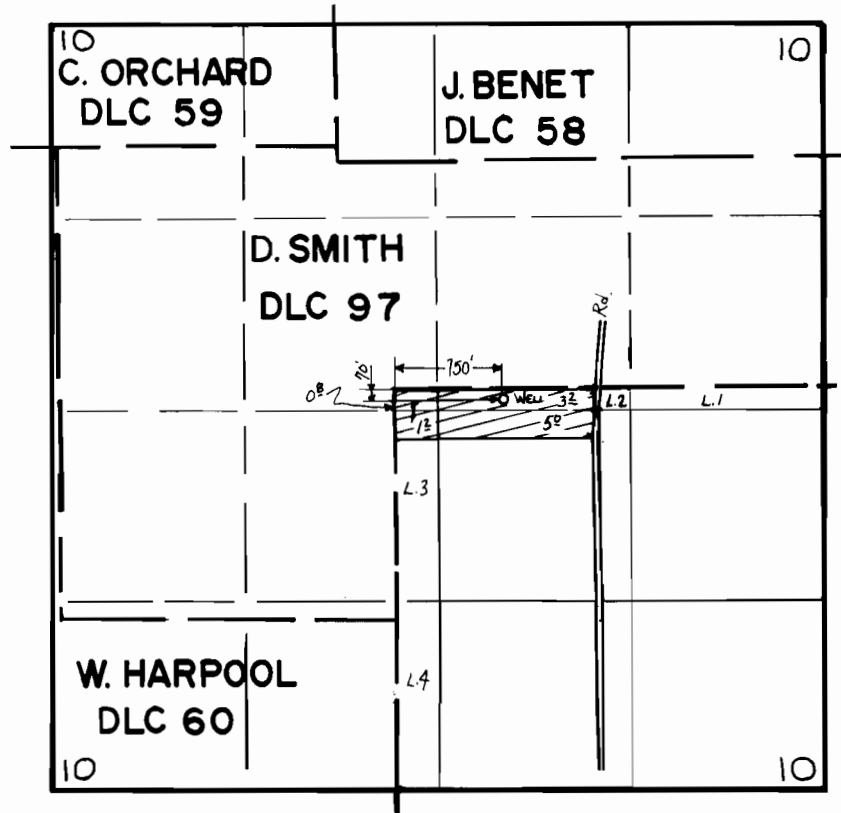

## FINAL PROOF SURVEY UNDER

Application No. **G.8889** Permit No. **G.8283**.  
IN NAME OF

**GALEN & RAYETTA WILSON**

Surveyed **OCT. 25, 1983**, by **M. CAHILL**.....