G-8301
58989

T. 2 S. R. 25 E. W.M.

N

Scale 1"= 1320'

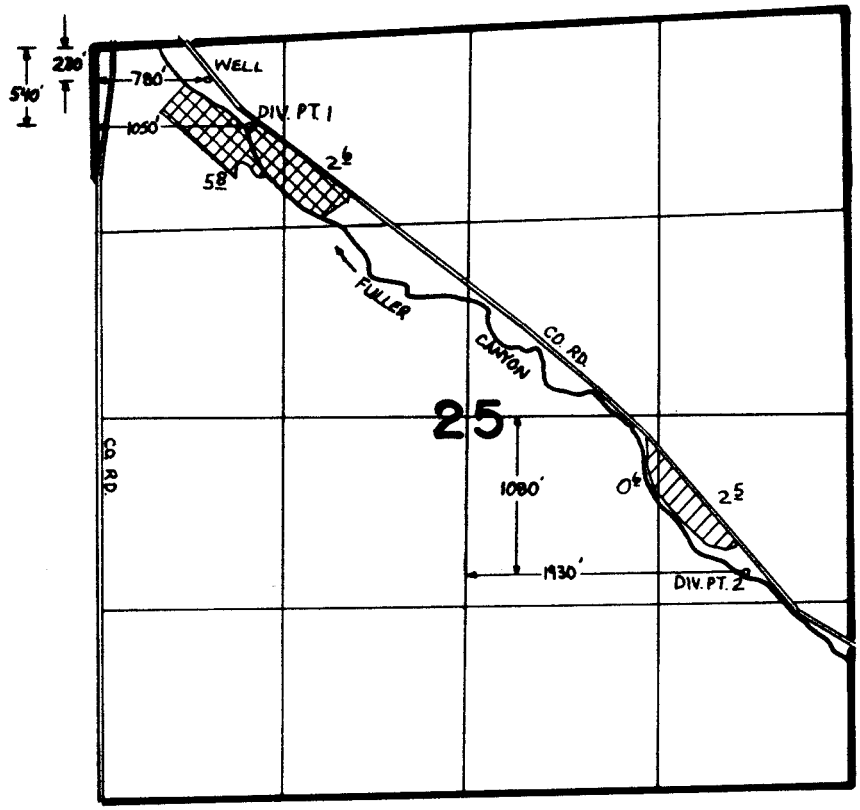

FINAL PROOF SURVEY

UNDER

57529 43528

Application No. G.8855 Permit No. G.8301

IN NAME OF

DEXTER M. MILES

Surveyed March 29 1986., by V. Church

278-175 R Lo SC